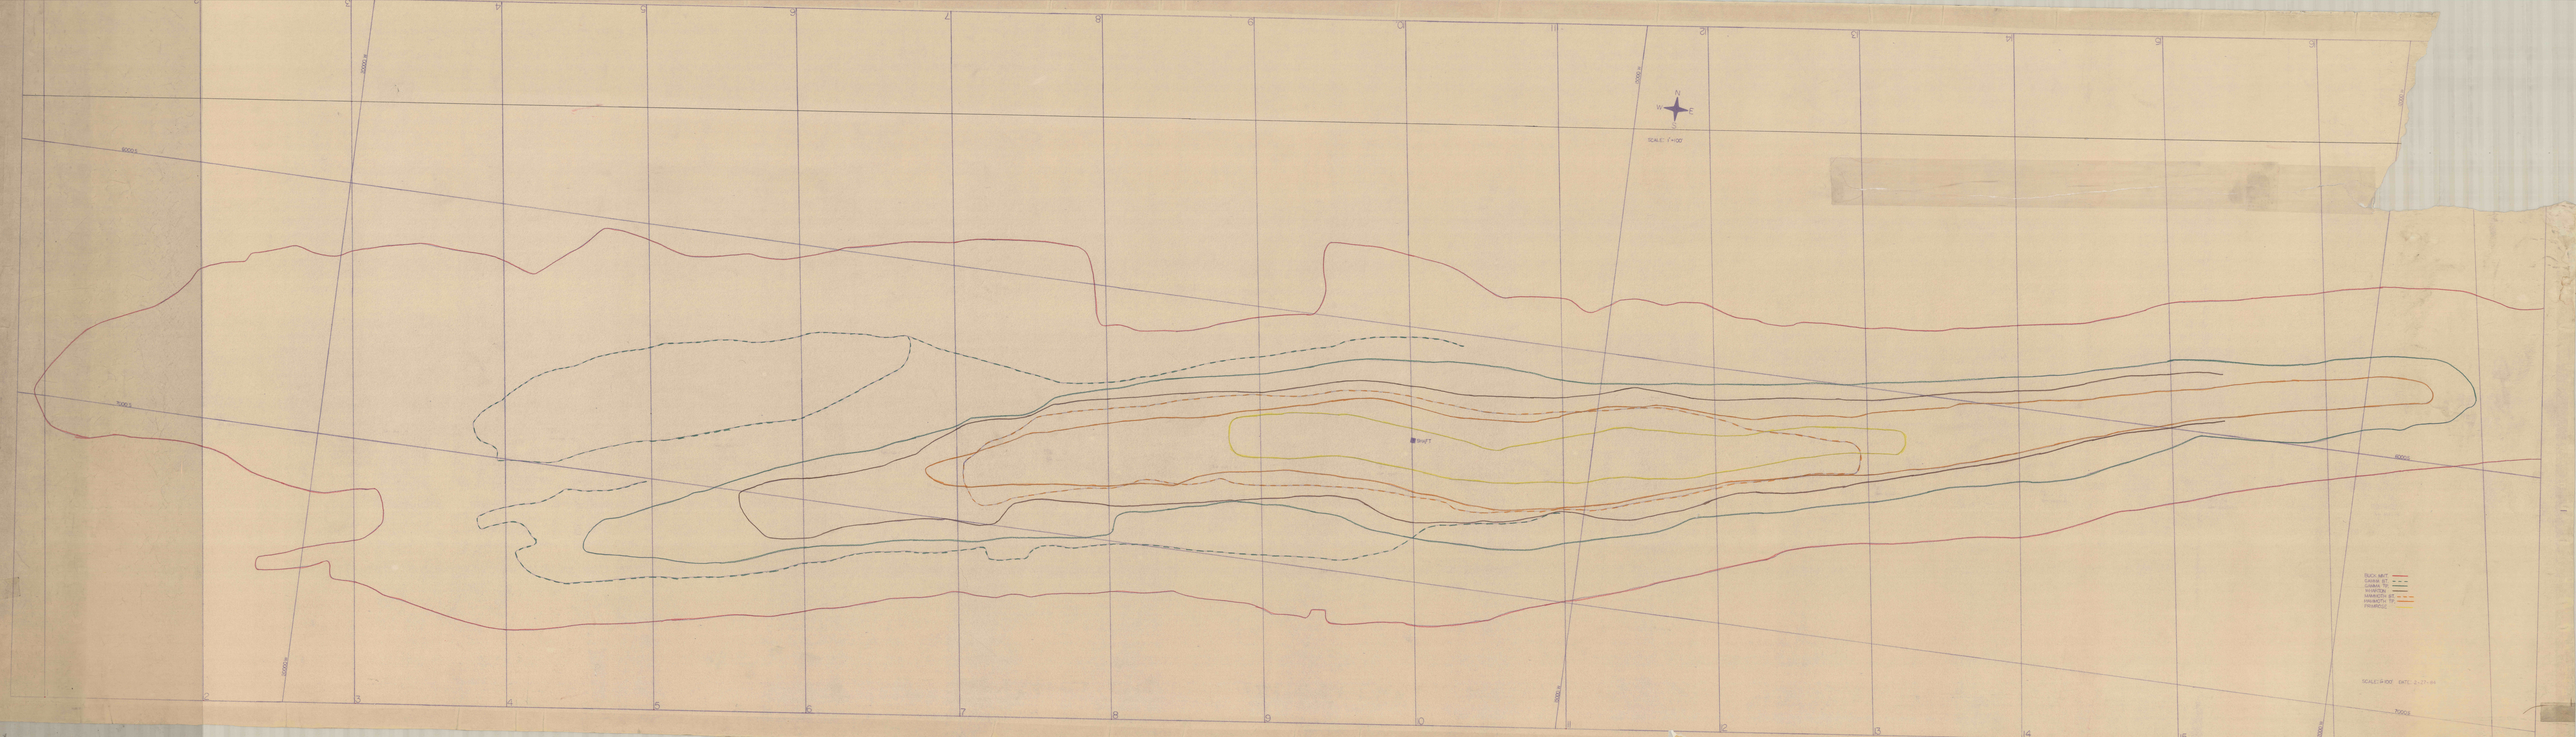
N
W
E
SCALE 1"=100'
8000 E
7000 E
6000 E
5000 E
BUCK ABT
LUANN TE
LUANN TE
WYANTON
WYANTON TE
HAMMOND TE
HAMMOND
PRIMROSE
