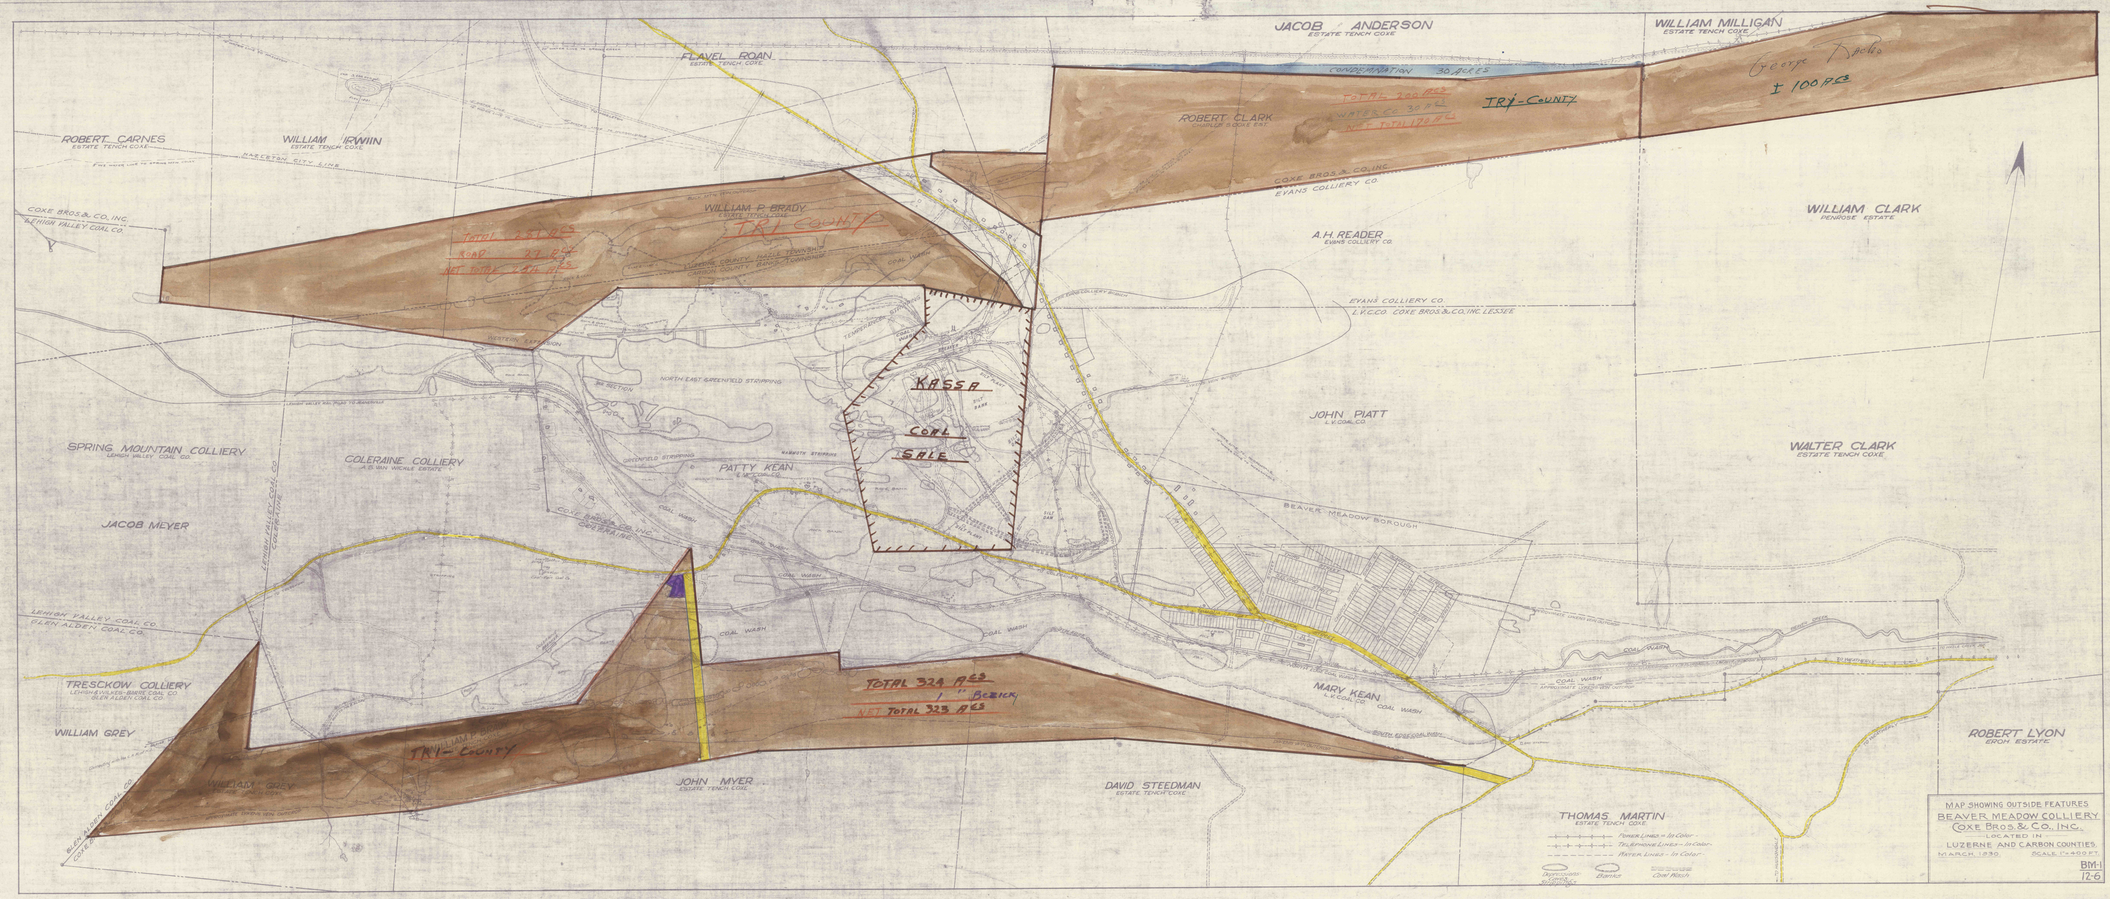

JACOB ANDERSON
ESTATE TENCH COXE
WILLIAM MILLIGAN
ESTATE TENCH COXE
FLAVEL ROAN
ESTATE TENCH COXE
CONDEMNATION 30 ACRES
George Dacko
± 100 A.C.S.
ROBERT CARNES
ESTATE TENCH COXE
WILLIAM IRWIN
ESTATE TENCH COXE
HAZLETON CITY LIMITS
ROBERT CLARK
SURFACE ONLY RIT.
TOTAL 200 ACS
WATER CO 30 A.C.
NET TOTAL 170 A.C.
TRI-COUNTY
COKE BROS & CO. INC.
EVANS COLLIERY CO.
COKE BROS & CO. INC.
LEHIGH VALLEY COAL CO.
WILLIAM P. BRADY
ESTATE TENCH COXE
TRI-COUNTY
TOTAL 450 ACS
ROAD 32 A.C.
NET TOTAL 418 A.C.
LUZERNE COUNTY HAZLE TOWNSHIP
CARBON COUNTY EAST TOWNSHIP
WESTERN SLOPE
NORTH EAST GREENFIELD STRIPPING
KASSA
COAL
SALE
A.H. READER
EVANS COLLIERY CO.
EVANS COLLIERY CO.
L.V.C.CO. COKE BROS & CO. INC. LESSEE
WILLIAM CLARK
PENROSE ESTATE
JOHN PLATT
L.V. COAL CO.
WALTER CLARK
ESTATE TENCH COXE
SPRING MOUNTAIN COLLIERY
LEHIGH VALLEY COAL CO.
COLERAINE COLLIERY
A.B. VAN WICKLE ESTATE
PATTY KEAN
L.V. COAL CO.
GREENFIELD STRIPPING
MARKETE STRIPPING
COKE BROS & CO. INC. LESSEE/RE
JACOB MEYER
LEHIGH VALLEY COAL CO.
COLLIERY
BEAVER MEADOW BOROUGH
LEHIGH VALLEY COAL CO.
ELEN ALDEN COAL CO.
TRESCKOW COLLIERY
LEHIGH & WILKES-BARRE COAL CO.
ELEN ALDEN COAL CO.
WILLIAM GREY
TOTAL 324 ACS
1" BEDROCK
NET TOTAL 325 ACS
TRI-COUNTY
WILLIAM GREY
JOHN MYER
ESTATE TENCH COXE
DAVID STEEDMAN
ESTATE TENCH COXE
MARY KEAN
L.V. COAL CO.
COAL WASH
ROBERT LYON
ERON ESTATE
THOMAS MARTIN
ESTATE TENCH COXE
POWER LINES - In Color
TELEPHONE LINES - In Color
WATER LINES - In Color
Buildings
Coal Wash
MAP SHOWING OUTSIDE FEATURES
BEAVER MEADOW COLLIERY
COKE BROS & CO. INC.
LOCATED IN
LUZERNE AND CARBON COUNTIES
MARCH 1930
SCALE 1"=400 FT.
BM-1
12-6