


CROSS SECTION ON LINE OF DDH 1356 SURFACE 1660  
 1" = 50'

CROSS SECTION ON LINE OF DDH 1357  
 SURFACE 1155 1" = 50'

CROSS SECTION ON LINE DDH 1357  
 SURFACE 1155 1" = 50'

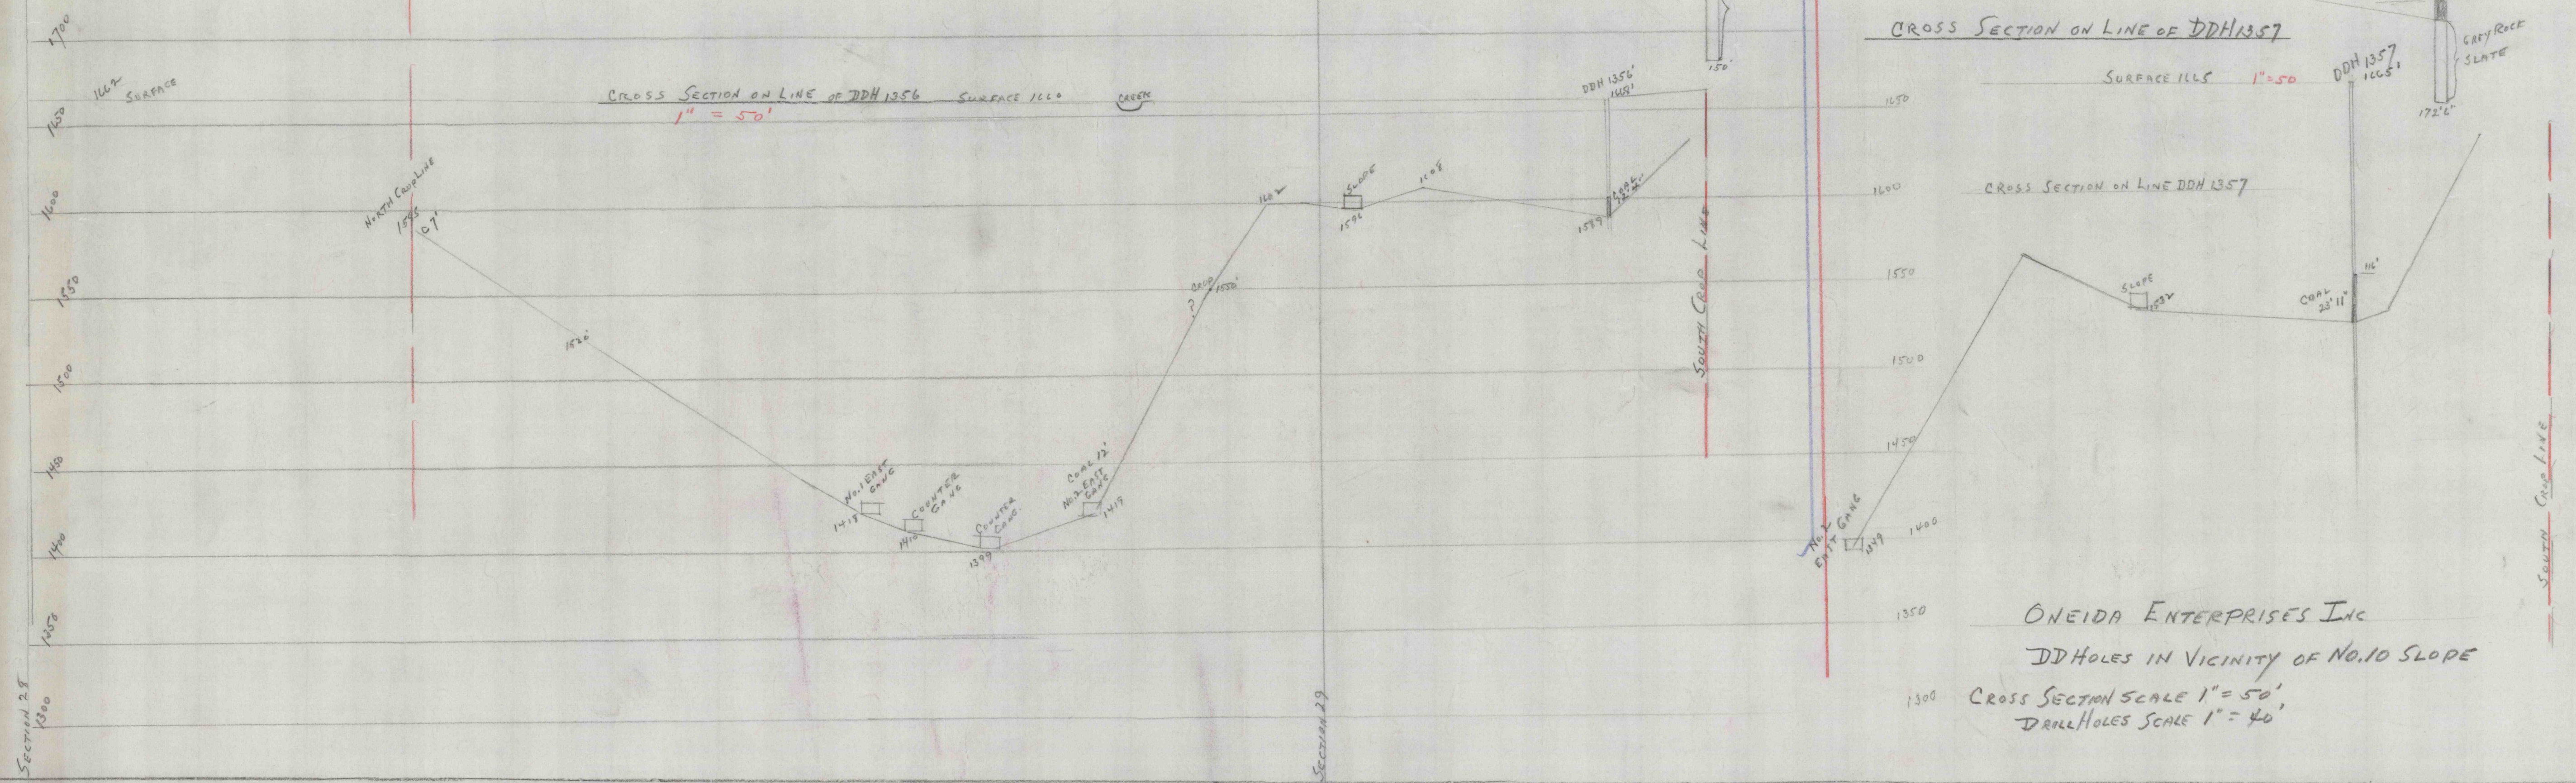

ONEIDA ENTERPRISES INC  
 DD HOLES IN VICINITY OF NO. 10 SLOPE  
 CROSS SECTION SCALE 1" = 50'  
 DRILL HOLES SCALE 1" = 40'

SECTION 28

SECTION 29

SECTION 30

800' SOUTH OF AIR SHAFR HOLE 1555