


LOOKING WEST

N



FLUME UNDER CONSTRUCTION
OLD FLUME

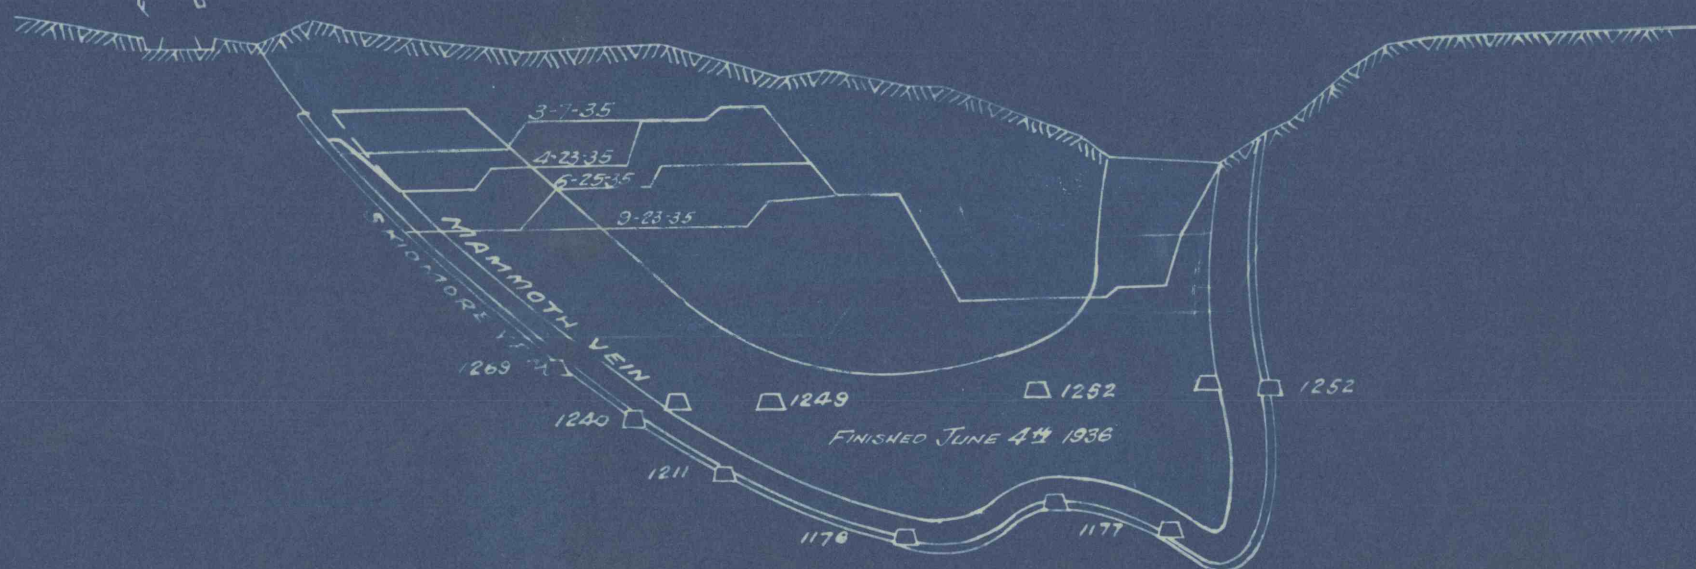

DATUM +1000 FEET

BASE NO 37

NO 16-A
MOREA COLLIERY
LINE NO 37
EAST BOTTOM LIMIT
SHAFT PILLAR STRIPPING
SCALE 1"=100' APRIL 30-1935

