


W 1000

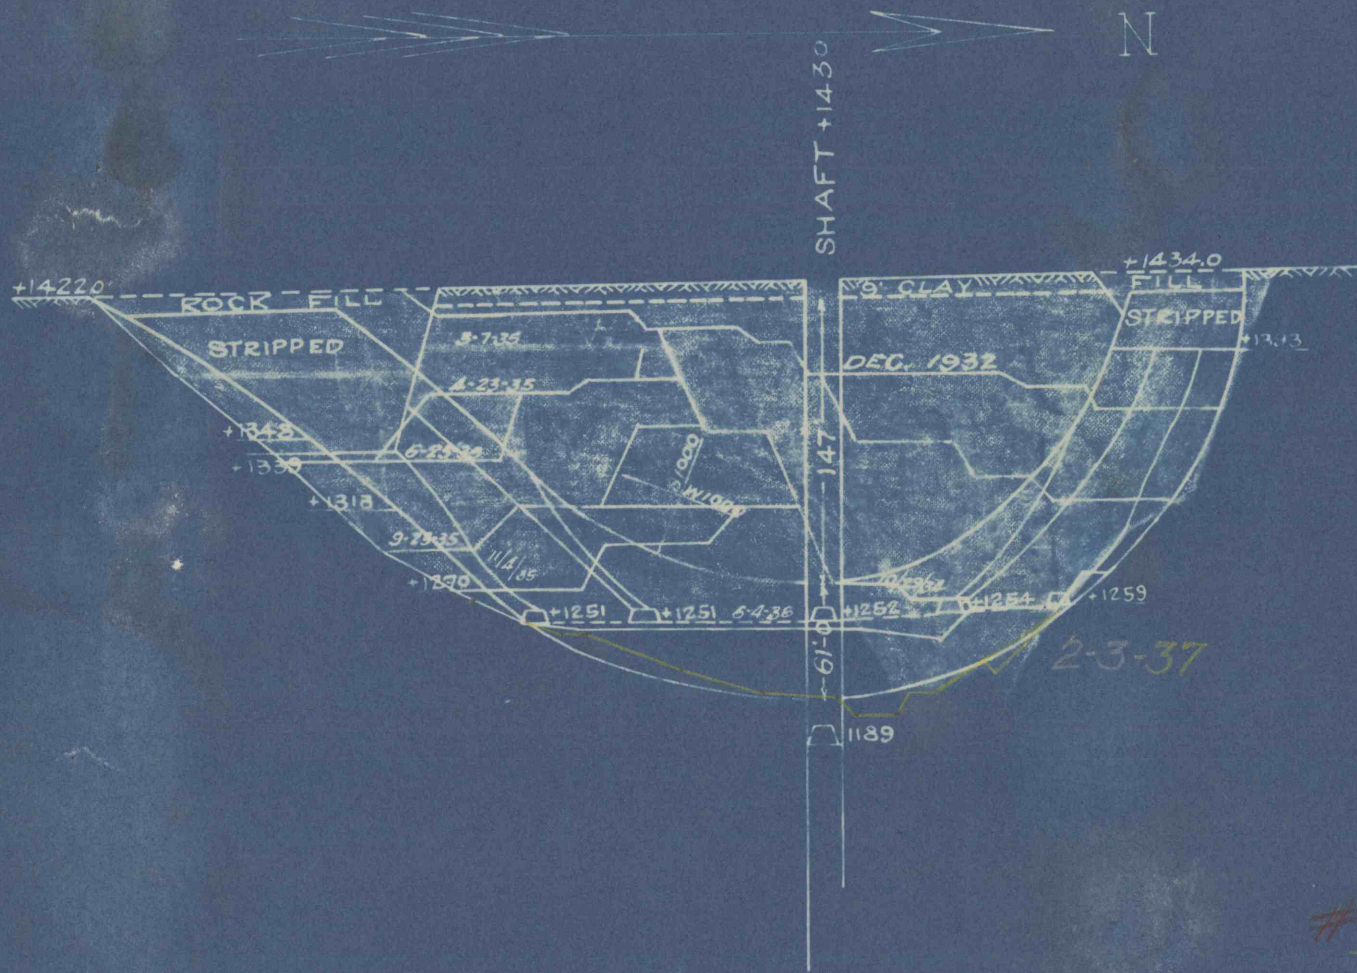

DATUM + 1000 FT.

MOREA COLLIERY
SHAFT PILLAR
SCALE 1" = 100 FT.

APRIL-15-1930

55500

W 1000