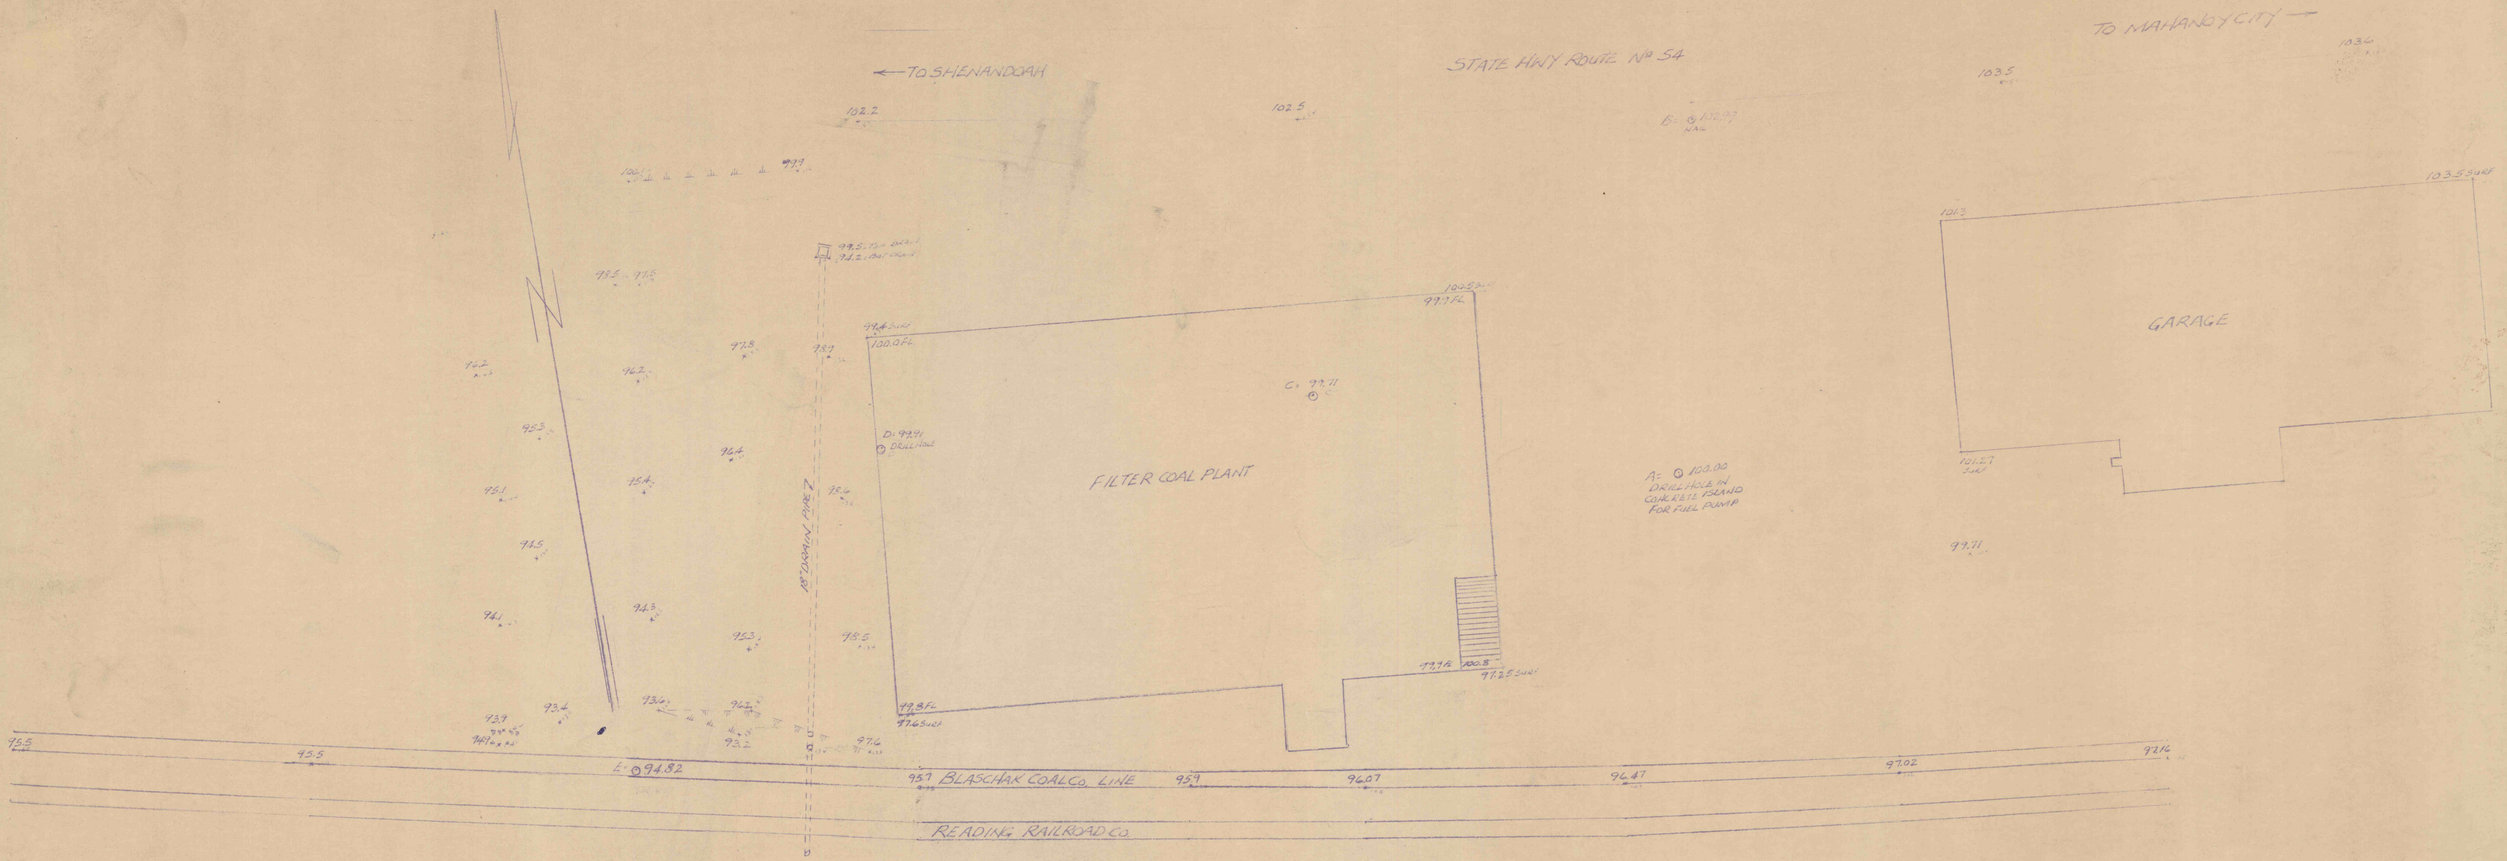

MAP SHOWING OUTSIDE FEATURES AT BLASCHAK COAL FILTER PLANT
LOCATED IN MAHANOY TWP. SCHUYLKILL CO. PENNA.

SEPT 4, 1976 SCALE 1" = 20' H.D. HARPER R.P.E. 12775