


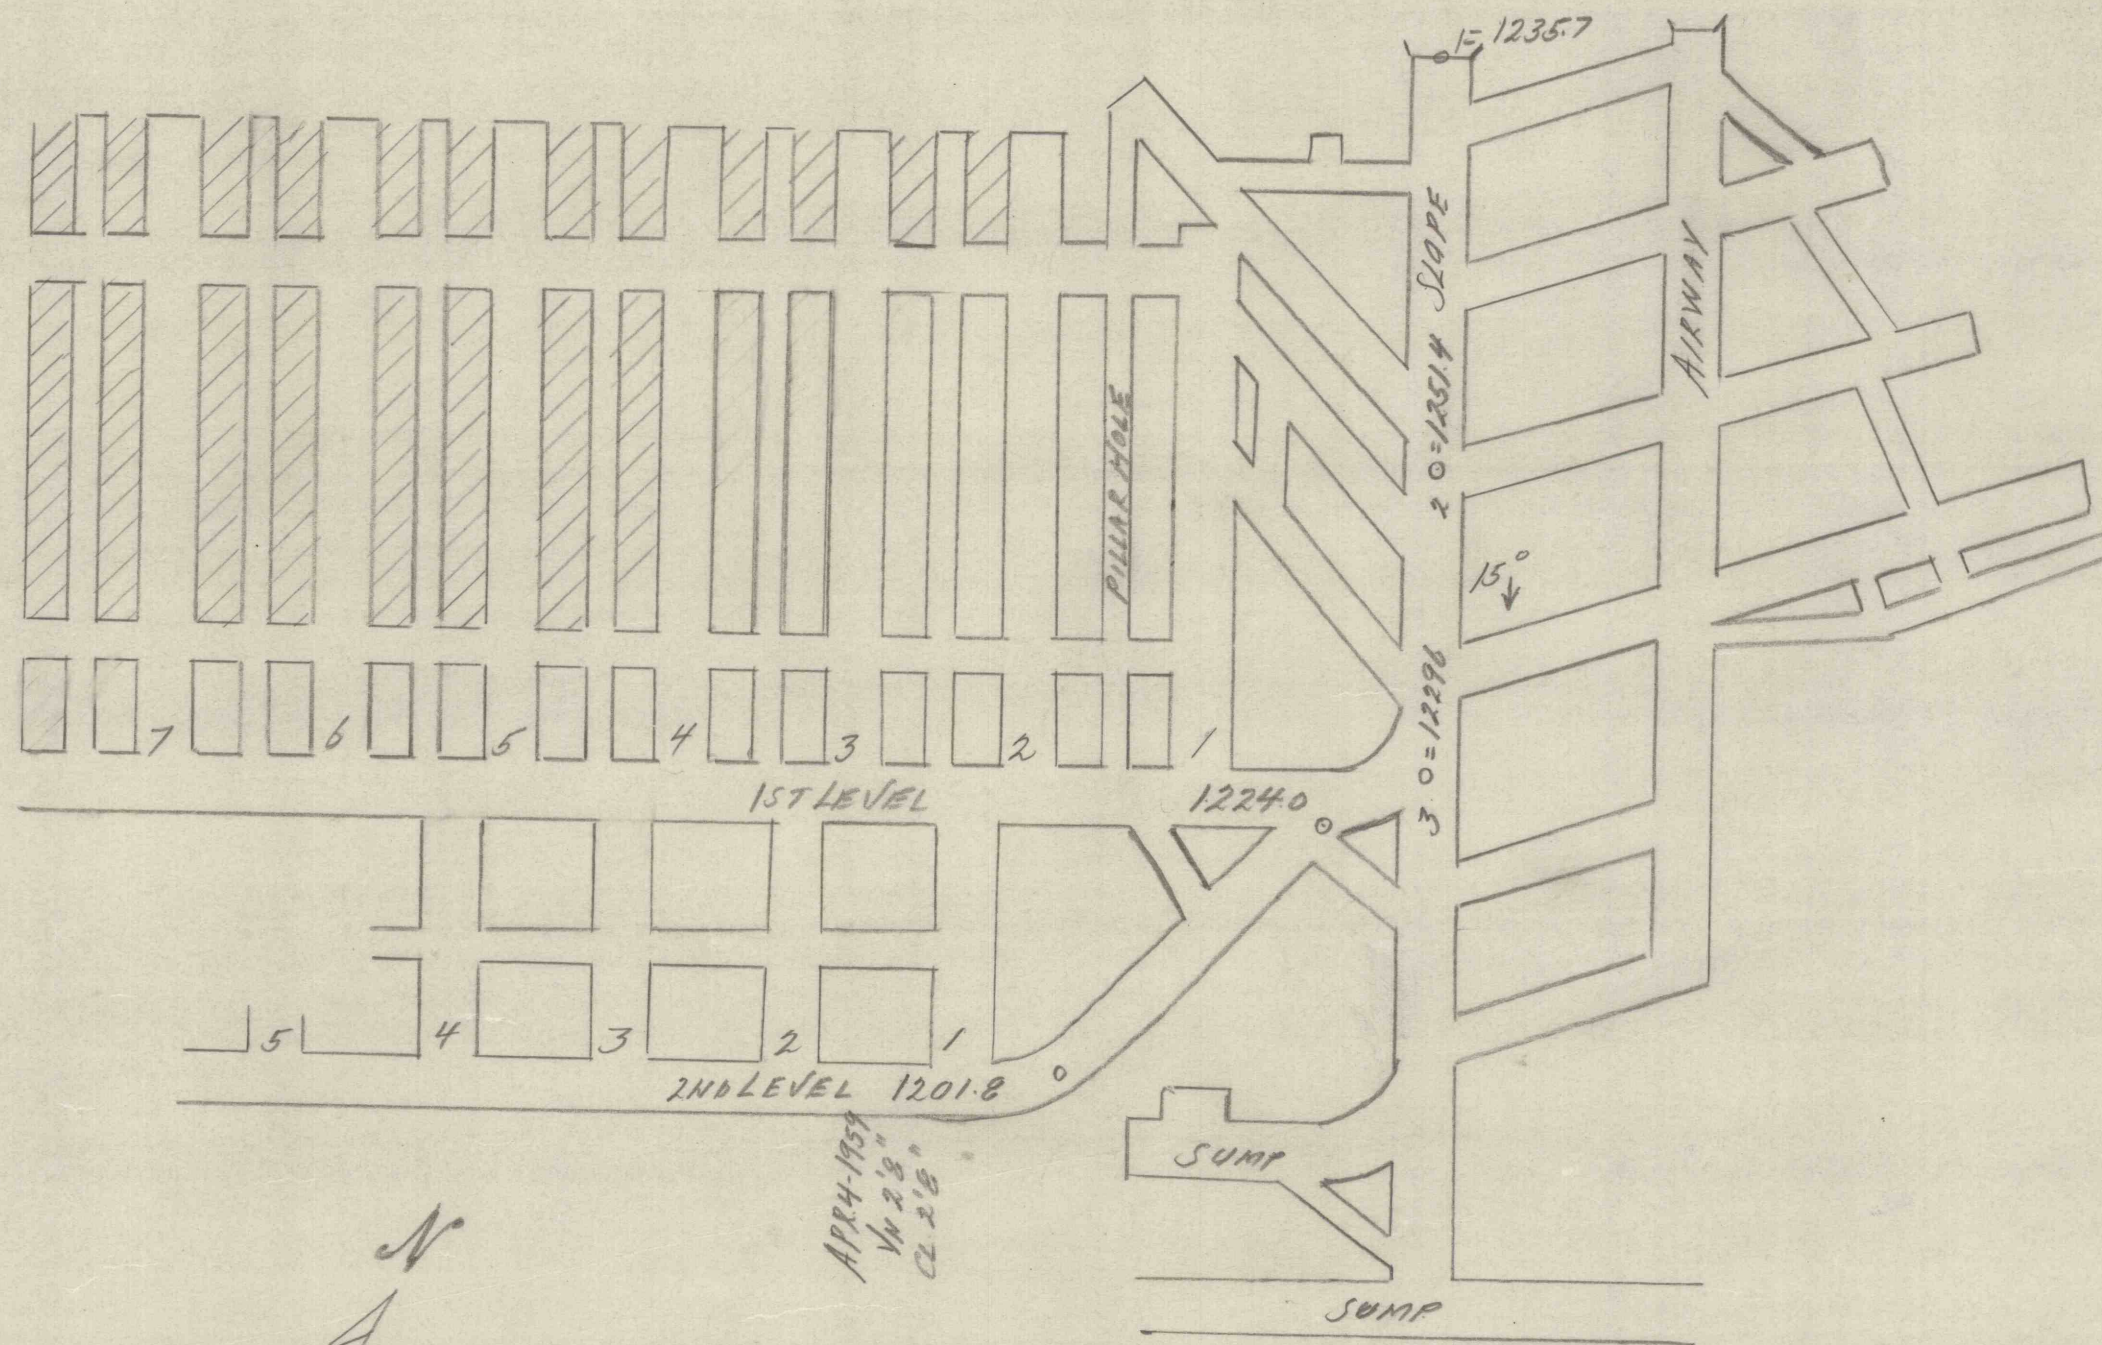

MAP SHOWING THE BOTTOM SPLIT
WORKINGS OF THE WANISKI MINE

SCALE 1"=50 FT

MAY-1959

HARRY REH P.E. #2461

PO20-MT-JAT