


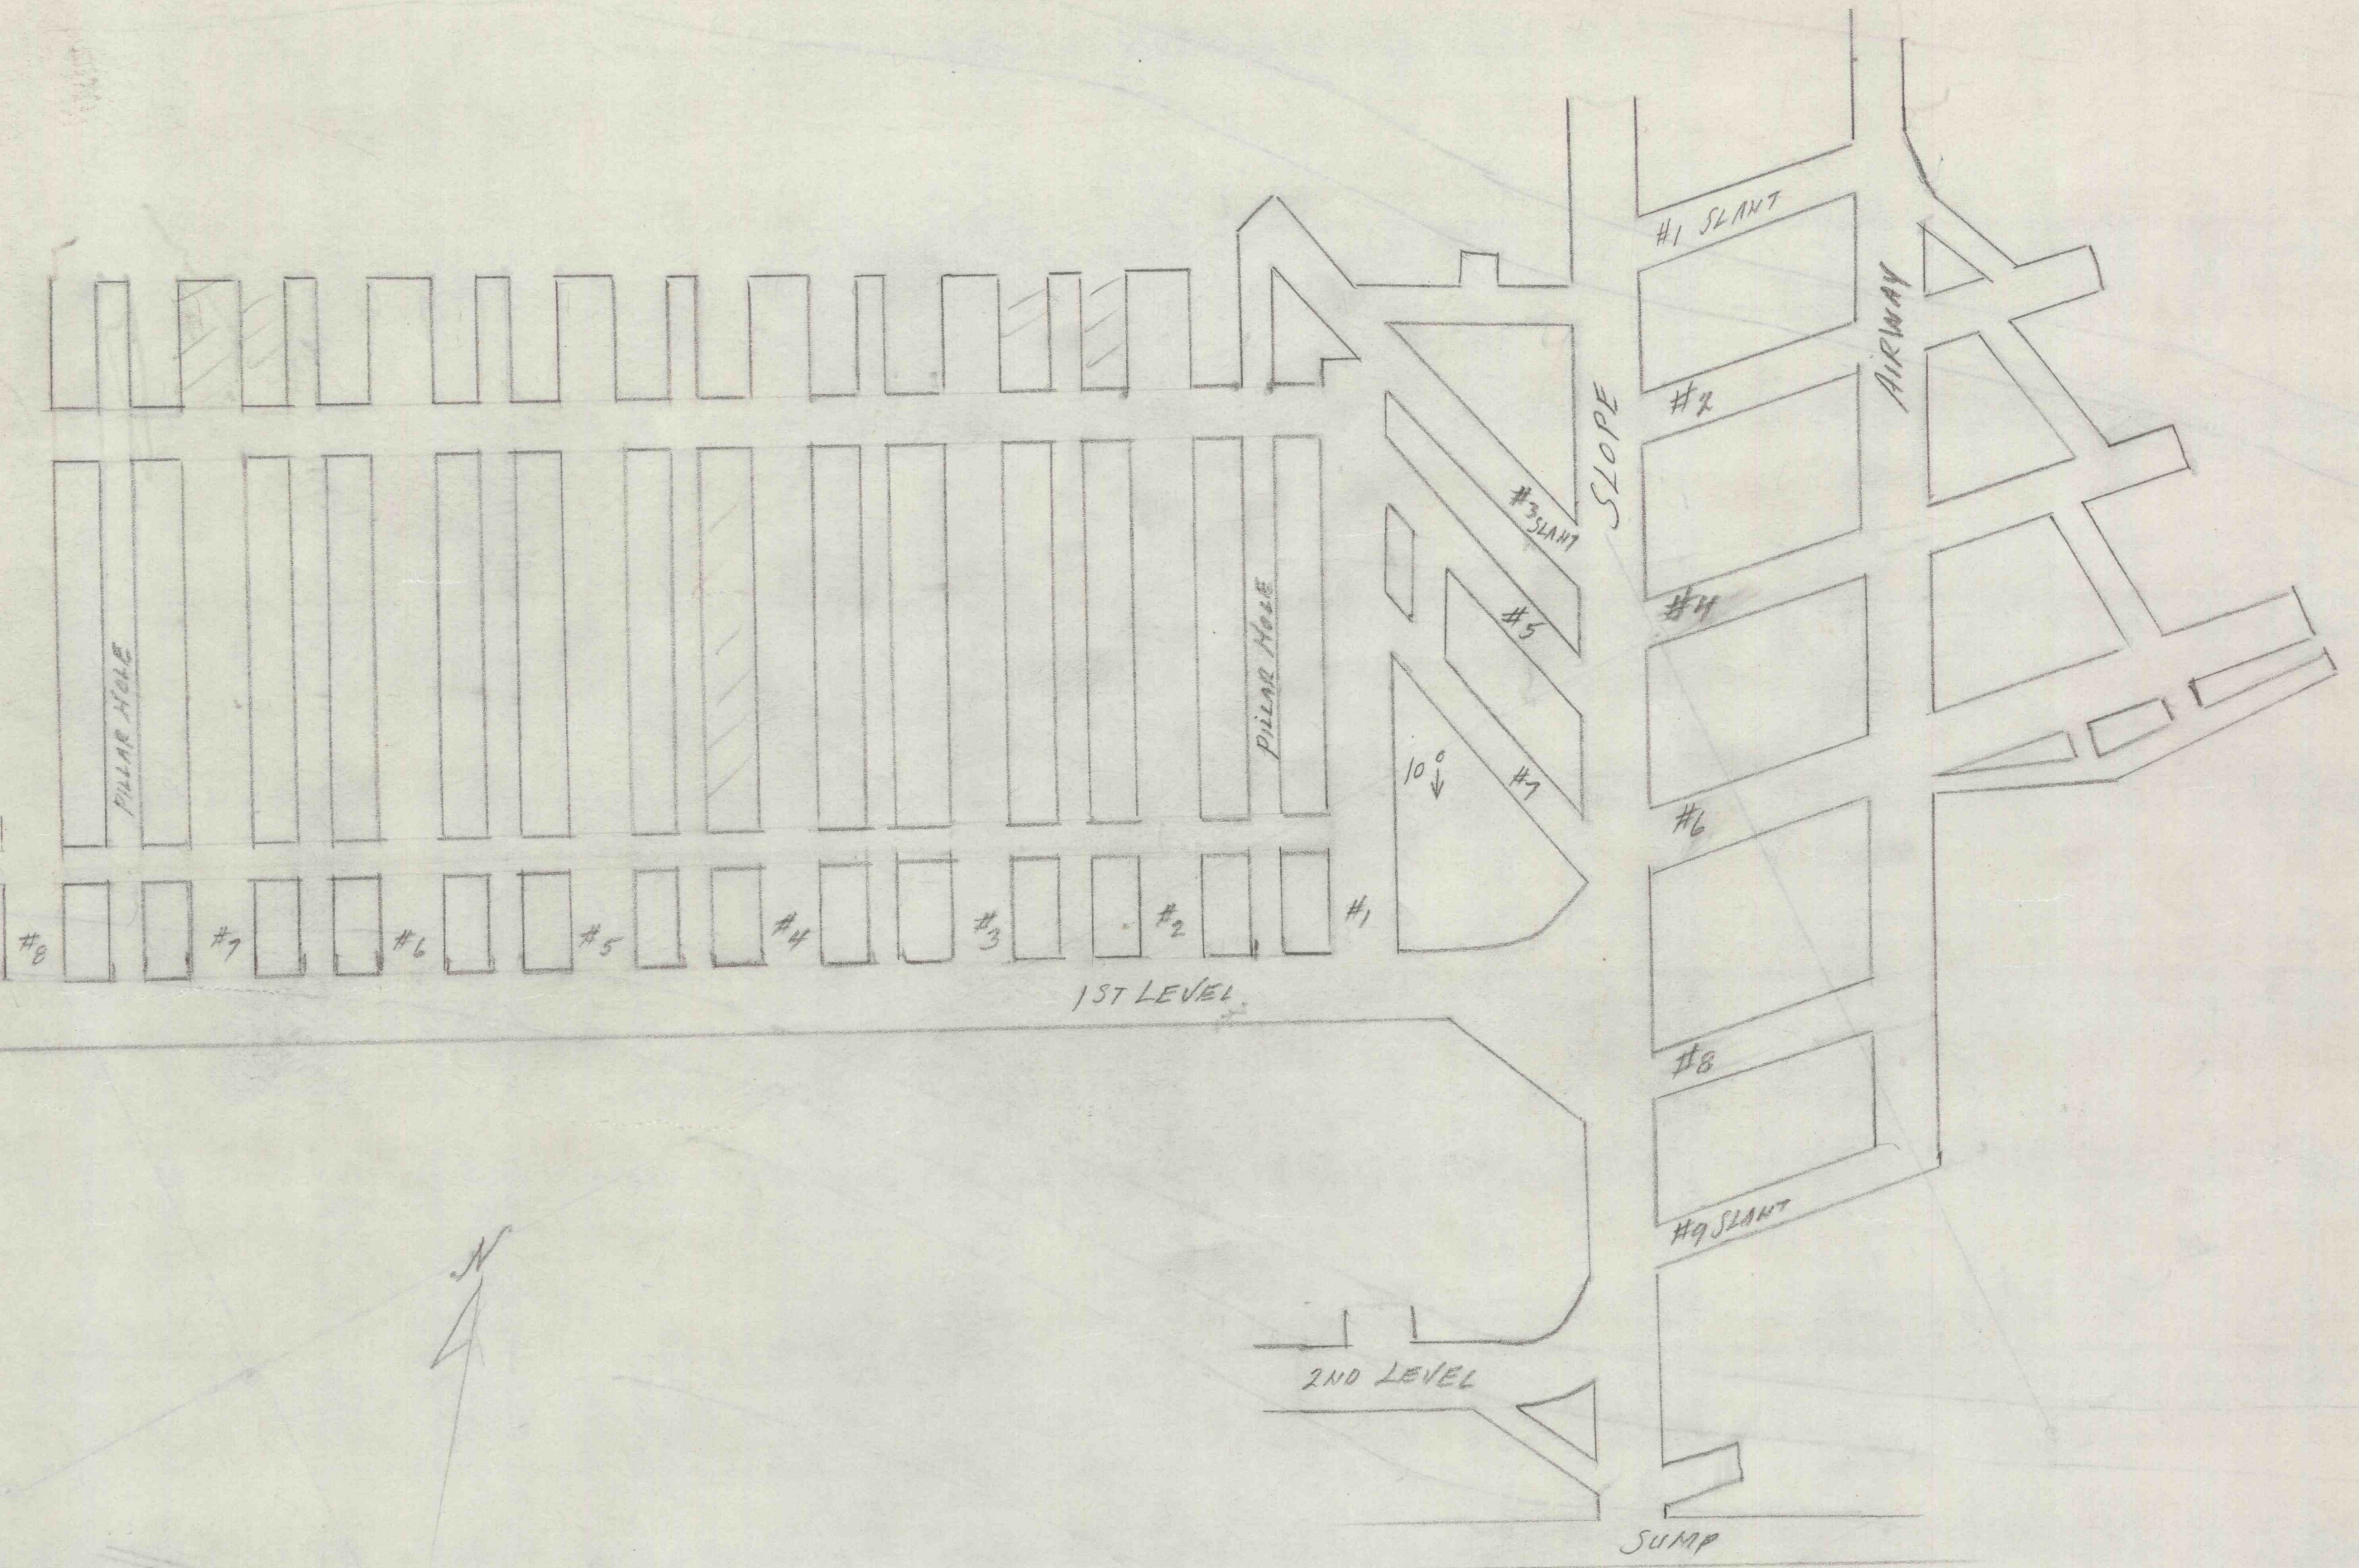

MAP SHOWING THE BOTTOM SPLIT
WORKINGS OF THE WANISKI MINE
SCALE 1" = 40 FT
DEC 1958