


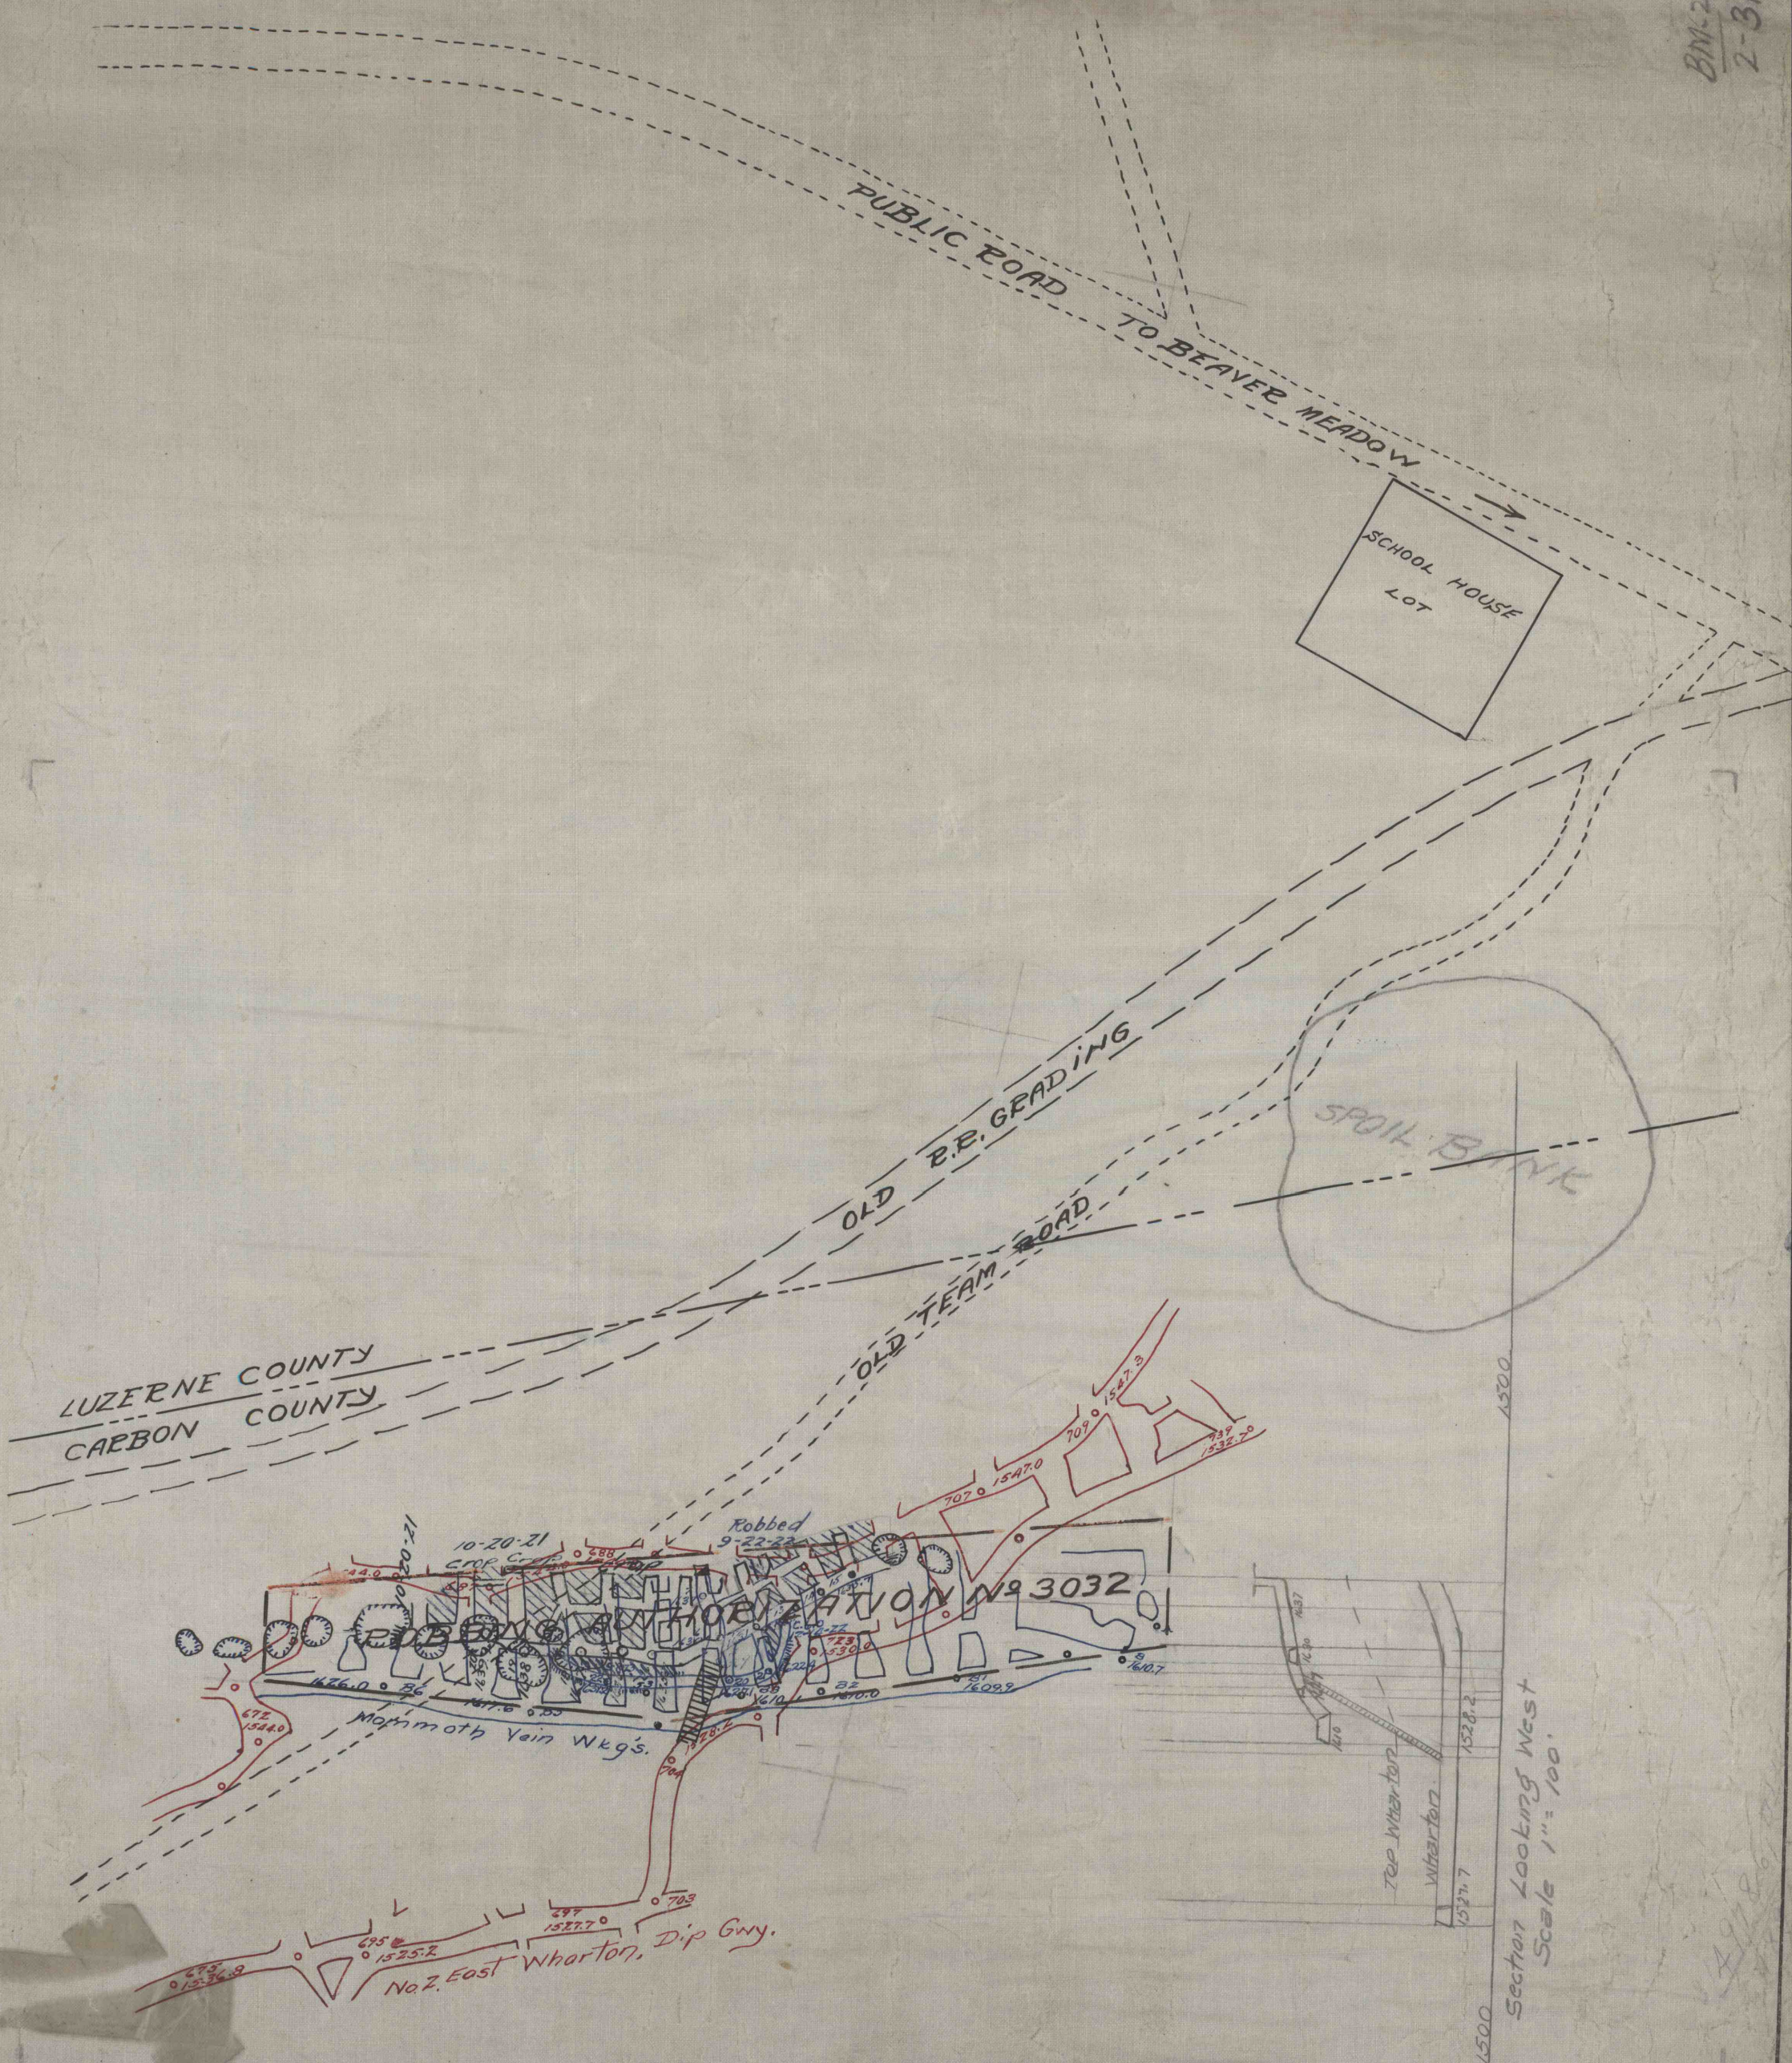

MAP SHOWING
NO. 6, SLOPE, MAMMOTH VEIN WKG'S, ABOVE NO. 2, E. WHARTON. GWY.
SCALE 1" = 100'
APRIL, 21, 1921.