
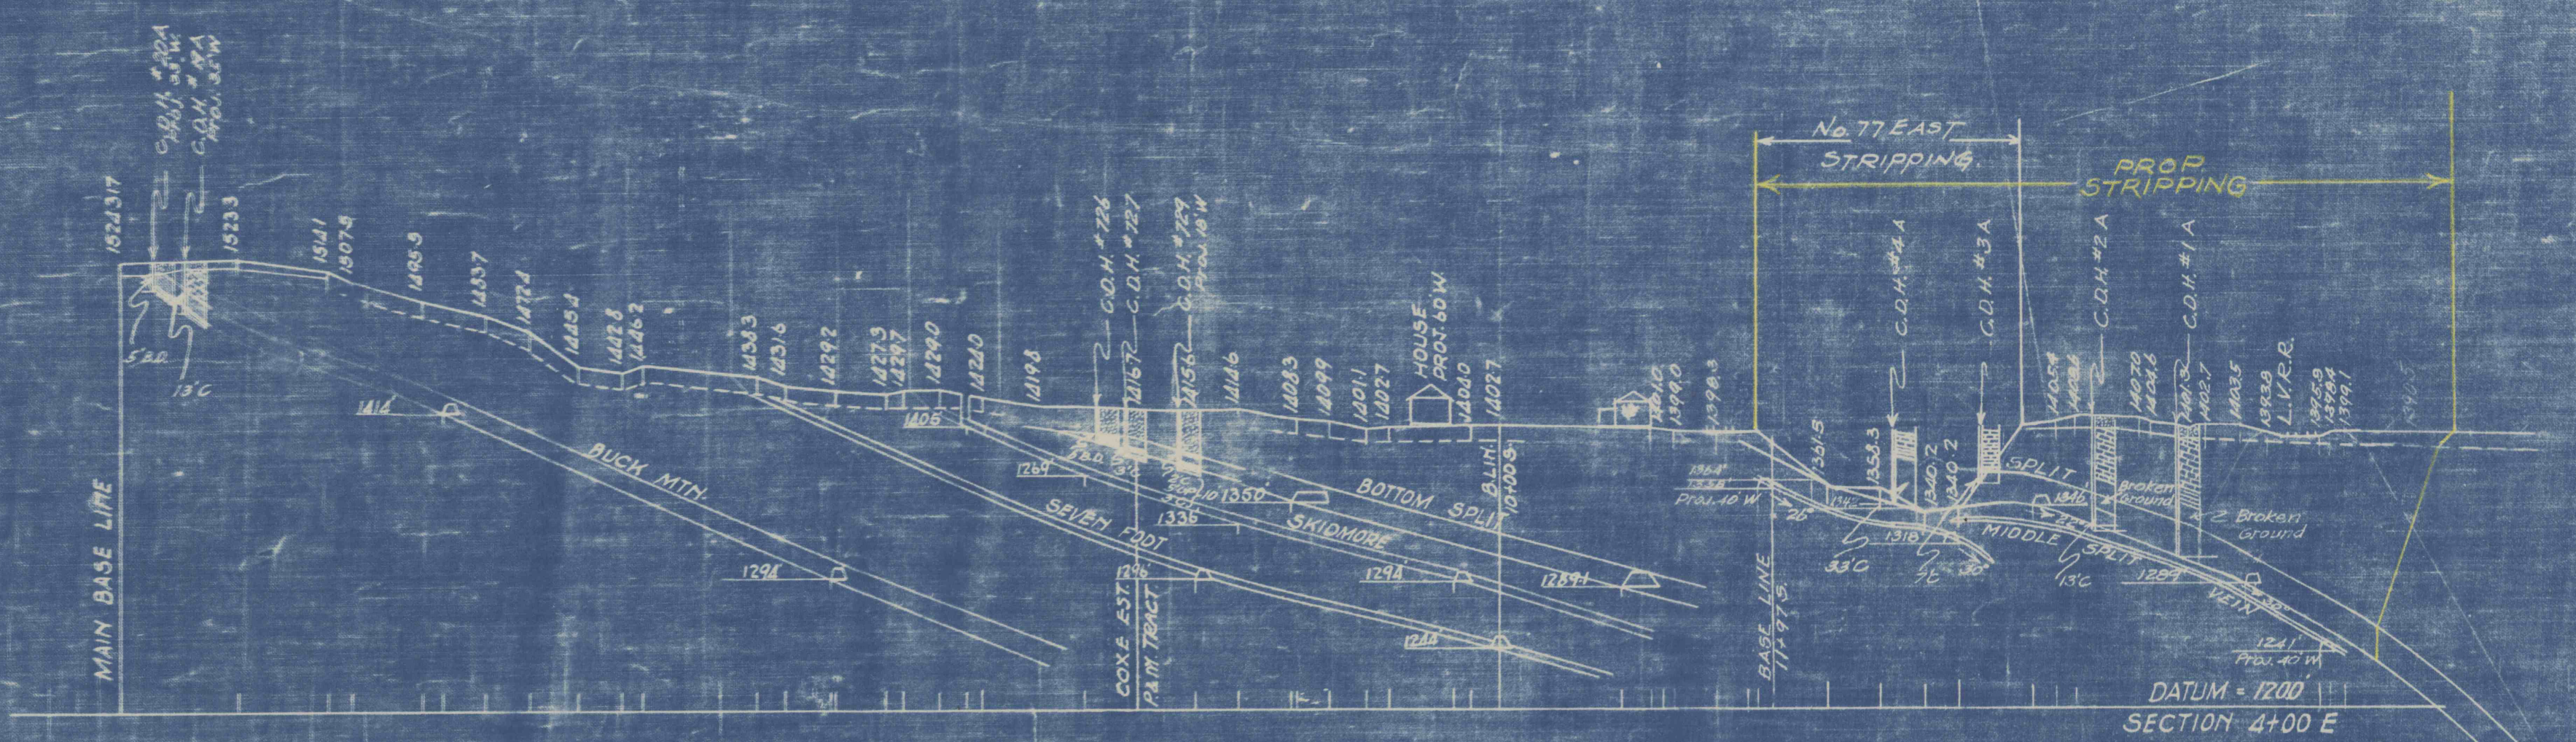
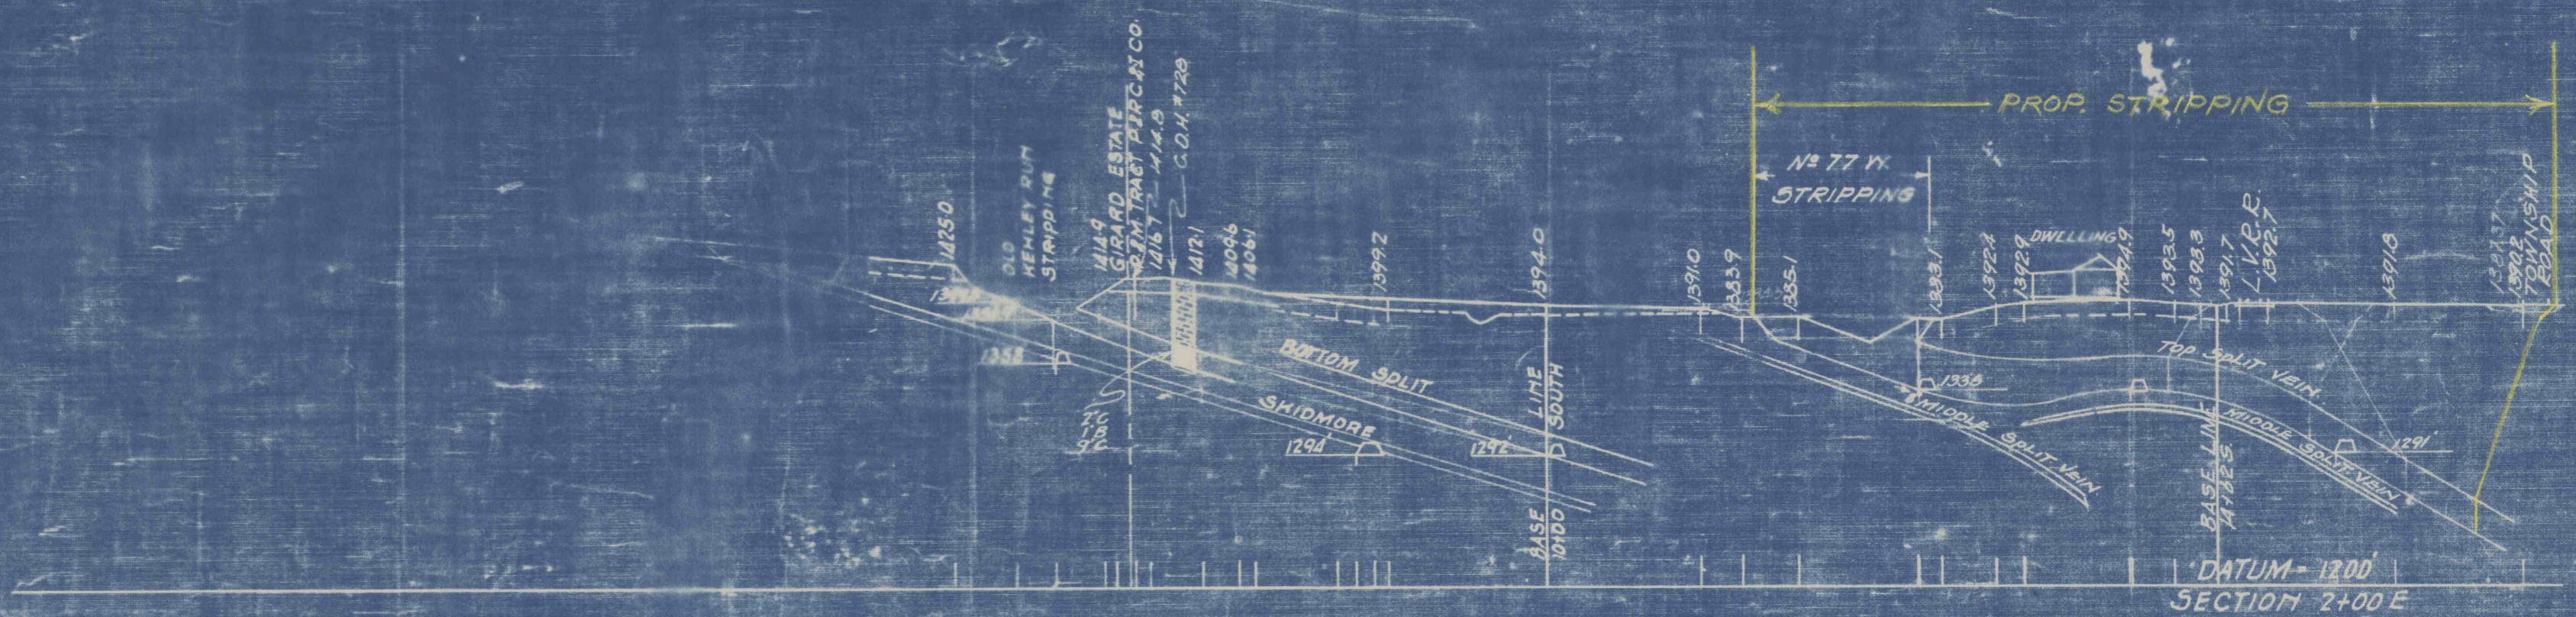


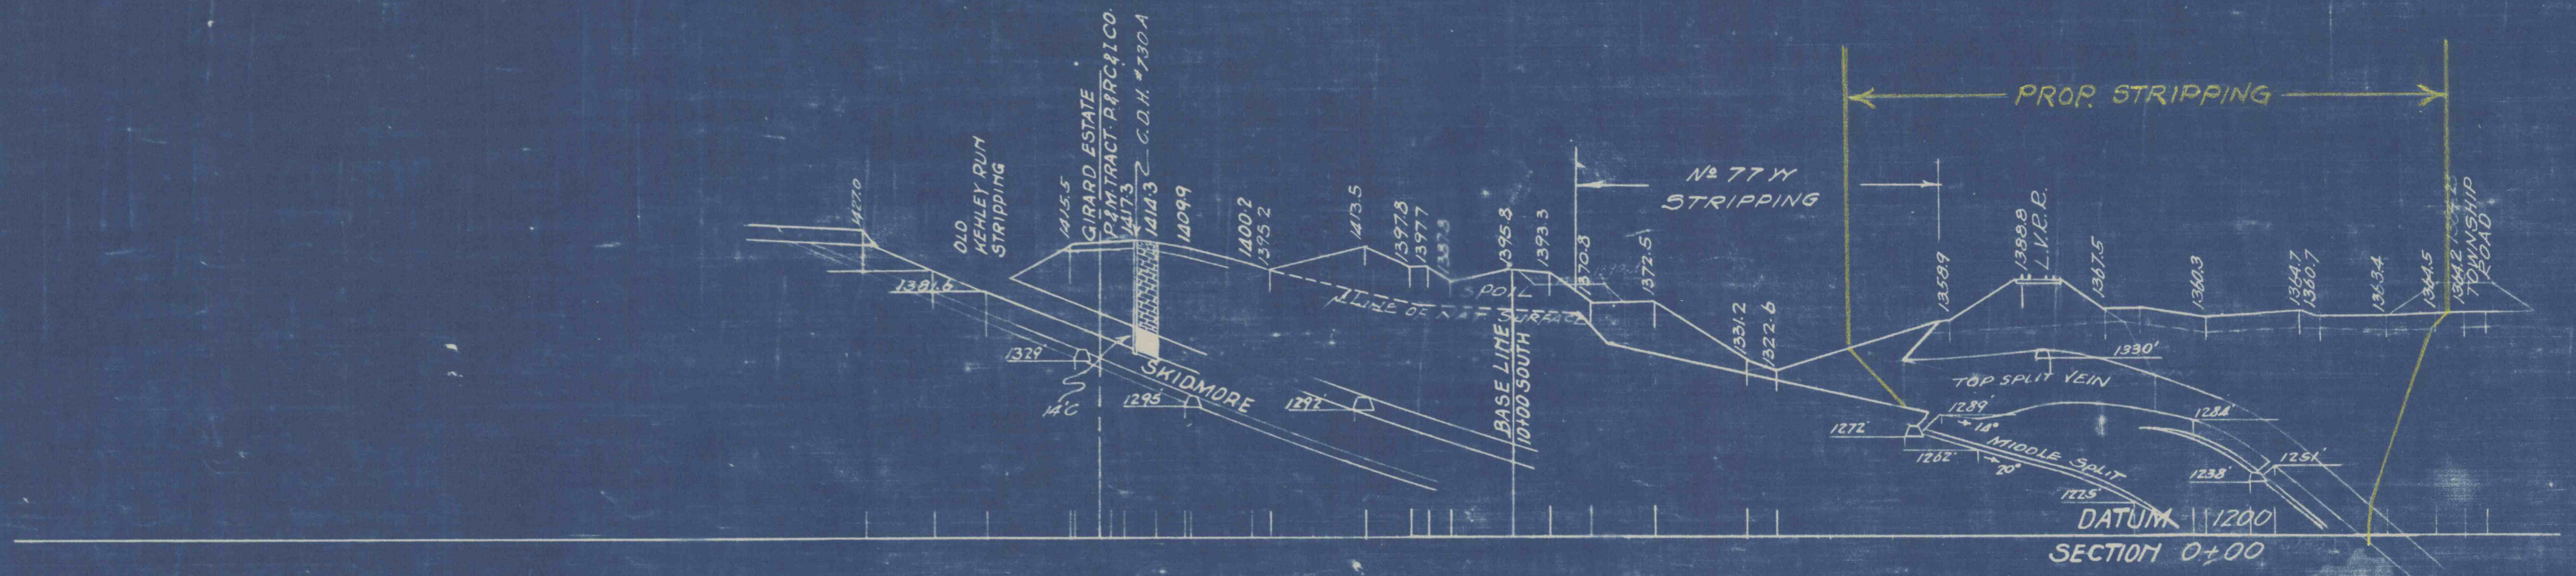

SHEN CITY - MAMMOTH VEIN STRIPPING
CROSS SECTIONS 0+00 TO 4+00 E INCL - LOOKING E
SCALE 1" = 100'