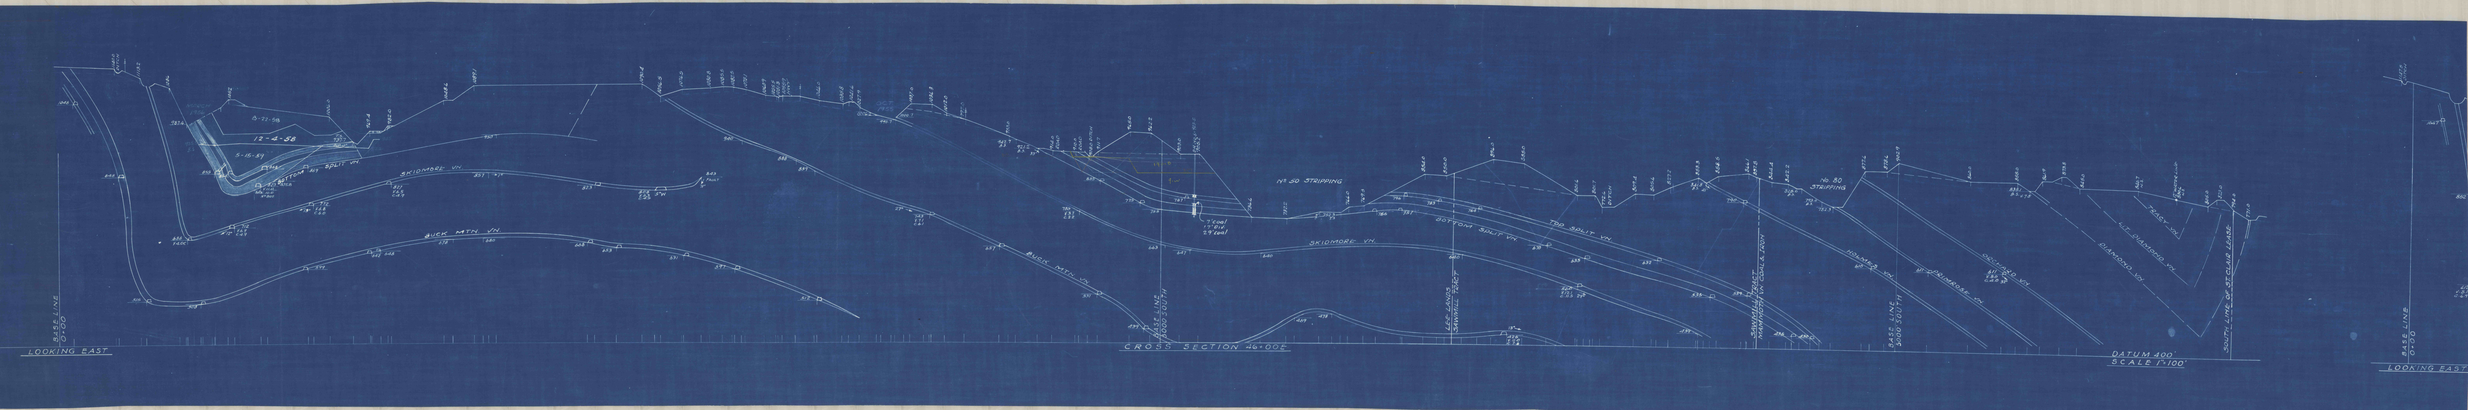

CROSS SECTION 46+00E
LOOKING EAST
DATUM 400'
SCALE 1"=100'
BASE LINE 0+00
BASE LINE 8000 SOUTH
BASE LINE 5000' SOUTH
LEE LANDS SAWMILL TRACT
SAWMILL TRACT MAMMOTH VN. COAL & IRON
SOUTH LINE OF ST. CLAIR LEASE
BUCK MTN. VN.
SKIDMORE VN.
BOTTOM SPLIT VN.
TOP SPLIT VN.
HOLMES VN.
PRIMROSE VN.
ORCHARD VN.
DIAMOND VN.
LIT. DIAMOND VN.
TRACY VN.
No 50 STRIPPING
No. 80 STRIPPING
MARCH 1956
OCT 1955
8-22-58
12-4-58
5-15-59
T.S. 937.7
DIP 0°
7' coal
17' DIV.
29' coal
FAULT
1140.0 DITCH
1113.2
1086
1052
1006.0
969.4
982.0
1048.6
1089.1
1090.4
1056.5
1076.5
1080.8
1085.5
1082.5
1078.1
1060.9
1055.5
1051.8
1055.7 HWY
1046.0
1035.8
1041.6
1027.9
1006.2
995.7
1000.7
1037.0
1036.3
1012.0
997.0
953.0
942.7 B.S.
921.2 B.S.
912.0 ROAD
910.0 ROAD
908.0 DITCH
911.7
965.0
962.2
903.0
D.H. NO. 5-903.5
905.2
734.6
732.2
752.3
766.0
769.3
851.0
850.0
896.0
885.0
801.6
801.7
772.6 DITCH
809.4
805.6
827.2
853.3
841.8 B.S.
858.5
866.1
857.8
844.4
842.2
828.0 B.S.
793.0 B.S.
782.3
877.6
878.6
902.9
860.0
858.0
835.1 B.S. V.7.8
861.9
873.8
845.0
840.7 N.S.
12" WATER LINE 830.6 N.S.
805.0
822.0
794.0
771.0
1147.5 DITCH
1047
852
1046
848
855
854
868
869
823 935.8
V.11.0
88SC 10.0
No BOT.
987.4
935.5 8.5
950
940
888
859
827 V.6.5 C.4.9
857 1°
823
808 V.5.3 C.4.5 5°W
843
71°
772 V.6.8 C.6.0 19°
712 V.6.9 C.4.9 12°
686 V.4.0C
515
508
599
642
648
678
680
668
653
631
597
512
27°
743 V.7.1 C.6.1
755 V.3.7 C.2.2
657
531
439
835
775
787
758
663
647
640
469
478
425 V.11.0 C.7.6 13°
796
783
764
766
751
670
635
632
560 V.12.1 C.11.5 29°
790
535
539
437
435
430
610
611
611 V.8.0 C.4.0 32°
612 V.8.1 C.6.9