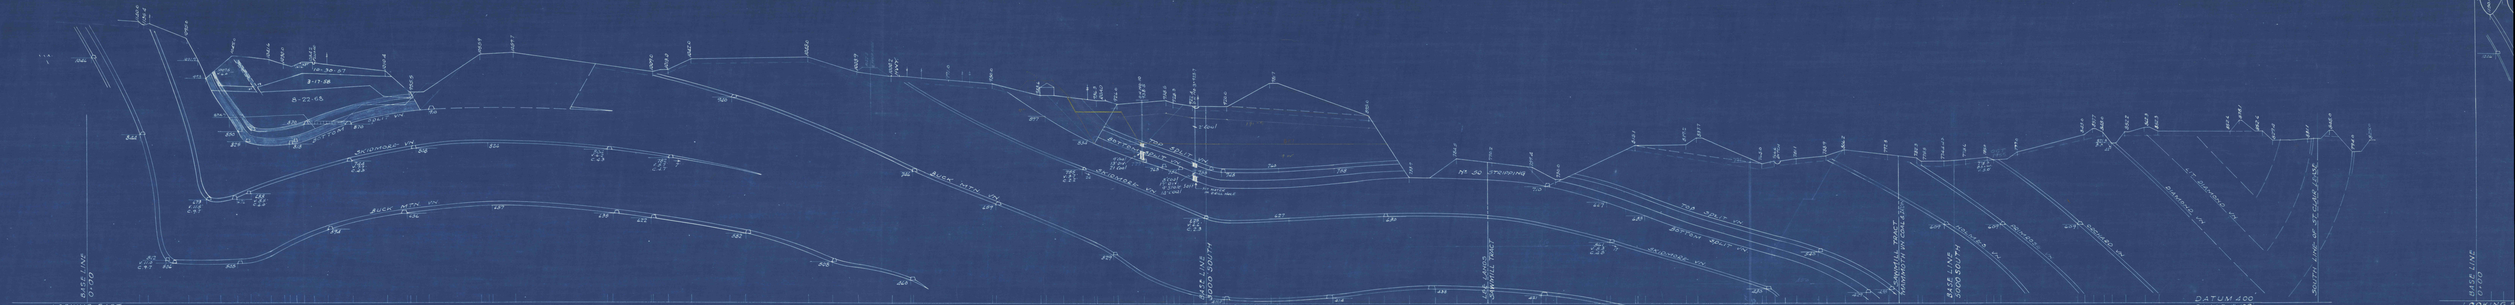

CROSS SECTION 42+00E

DATUM 400'
SCALE 1"=100'

LOOKING EAST
BASE LINE 0+00
BASE LINE 3000' SOUTH
BASE LINE 5000 SOUTH
BASE LINE 0+00
LOOKING E
LEE LANDS SAWMILL TRACT
SAWMILL TRACT MAMMOTH VN COAL & IRON
SOUTH LINE OF ST. CLAIR LEASE
1120.0
1135.4
1095.0
1031.9
1045.0
1041.6
1030.0
1028.2 FLUME
1010.4
955.5
1055.9
1059.7
1009.0
1013.0
1042.0
1048.0
1046
1007.5 V.6.0
993
10-30-57
3-17-58
8-22-68
886.7
870
850
825
818
BOTTOM SPLIT VN.
870
910
940
844
SKIDMORE VN.
808
824
744 V.7.7 C.4.3
804 V.6.2 C.4.3
782 V.5.7 C.4.7
7°
673 V.11.5 C.9.7
676
688 V.8.5 C.6.0
BUCK MTN. VN.
636
657
635
622
582
591
512 V.11.0 C.9.7
506
505
508
1008.9
1000.2 HWY.
991.0
980.0
948.6
943.3 ROAD
926.0
D.H. NO. 10 938.5
938.5
928.3
922.4 D.H. NO. 3 923.7
920.0
951.7
895.0
897
834
TOP SPLIT VN.
BOTTOM SPLIT VN.
2' Coal
9' Coal
13' DIV.
21 Coal
8' coal
17' DIV.
9' Slate Soft
12' coal
HIT WATER IN DRILL HOLE
763
756
755
728
760
758
746
755 V.3.7 C.2.2
24°
733.9
784.6
770.2
759.4
730.0
710
No. 50 STRIPPING
659
625 V.6.6 C.2.3
627
630
529
508
460
411.0
414
438
421
375.3 V.9.0 C.8.4
667
633
561 V.5.3 C.4.5
17°
818.1
819.2
837.7
791
768.0
766.6 DITCH
781.1
788.9
806.2
792.3
782.3
775.5
774.4
778.6
780
OCT 1955
799.0
843.0
857.7
848.0
821.5
852.2
862.3
852.3
852.6
878.1
852.6
829.4
831.1
848.0
794.0
825.0
1120.
1187.
1130.0
1046
TOP SPLIT VN.
BOTTOM SPLIT VN.
SKIDMORE VN.
540
430
429
436
283 V.9.5 C.4.0
257 V.12.6 C.4.0 15°
609
HOLMES VN.
609
PRIMROSE VN.
609
ORCHARD VN.
DIAMOND VN.
LIT. DIAMOND VN.
PROP. C.&H.
480 TONS