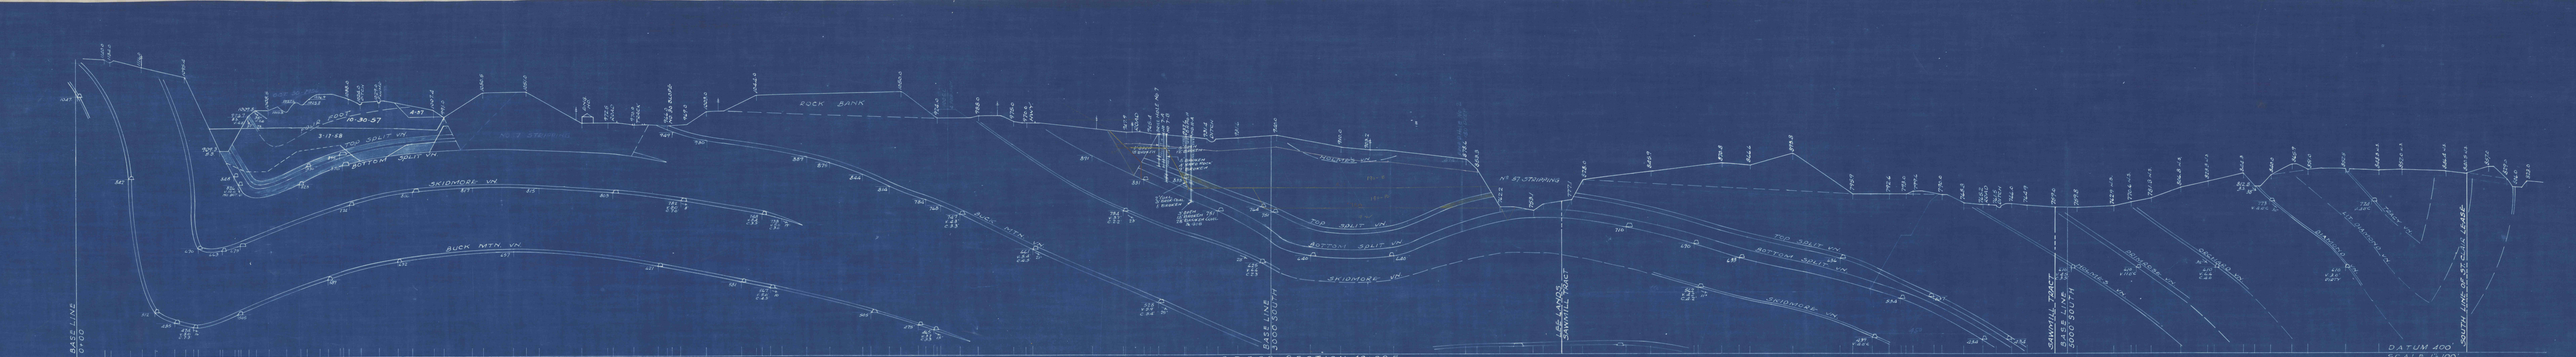

1140.0
1182.0
1116.0
1095.4
1047.
842
OCT. 30-1956
1009.8
1008.5
1010.8
1027.6
1034.9
1025.8
1038.0
1024.0 DITCH
1029.0 FLUME
1007.4
991.0
993.7 B.S. V.4.0
95' V.2.0
37
76
FOUR FOOT
10-30-57
4-57
3-17-58
TOP SPLIT VN.
BOTTOM SPLIT VN.
909.3 B.S.
848
826 V.10.0 NO BOT. 10
895
870
870
823
1050.5
1051.0
ENG. HO.
972.6 ROAD
970.0 TRACK
966.0 NO 30 SLOPE
969.0
1003.0
1044.0
ROCK BANK
1050.0
NO. 57 STRIPPING
949
930
889
875
844
814
784
768
747 V.4.3' C.3.3'
SKIDMORE VN.
806
817
815
803
774
782 V.8.0 C.7.0' 8'
748 V.8.4 C.3.5
738 V.5.0 C.3.0 19'
670
663
675
BUCK MTN. VN.
632
657
589
621
581
567 V.5.0 C.4.5' 10
512
485
474 V.8.0 C.7.3' 16'
505
505'
475
465 V.3.7 C.3.3 15'
BUCK MTN. VN.
661 V.5.4' C.4.5' 21'
528 V.5.9 C.5.4' 25'
974.0
988.0
975.0
970.0 HWY.
891
947.9 ROAD
945.4
DRILL HOLE NO 7
NO 7-A
NO 7-B
937.6
NO. 11
NO. 11-A
931.4 DITCH
931.6
940.0
6' OPEN 18' BROKEN
5' OPEN 12' BROKEN
5' BROKEN 4' HARD ROCK 9' BROKEN
831
835
754 V.3.7' C.2.2' 23'
2' COAL 3' BROK. COAL 6' BROKEN
3' OPEN 15' BROKEN 28' BROKEN COAL & GOB
751
764
751
20'
625 V.6.6 C.2.3
910.0
903.2
HOLMES VN.
DRILL HOLE NO 2 180' DEEP
878.6
853.3
190-B
190-B
9-W
Nº 57 STRIPPING
762.2
753.1
777.1
828.0
845.9
870.8
866.6
873.8
TOP SPLIT VN.
BOTTOM SPLIT VN.
SKIDMORE VN.
640
640
710
670
633
636
562 V.4.2' C.4.2' 11°
534
637
439 V.4.0'C
434
434
BASE LINE 3000' SOUTH
LEE LANDS SAWMILL TRACT
795.9
792.6
793.0
799.6
790.0
768.3
765.2 ROAD
761.5 DITCH
766.0
764.9
759.0
759.8
762.9 N.S.
770.6 N.S.
781.3 N.S.
806.8 N.S.
823.3 N.S.
844.3
812.8 B.S. 38°
840.0
865.9
851.0
852.5
848.3 N.S.
852.0 N.S.
846.4 N.S.
840.5 N.S.
857.0
829.0
806.0
823.0
773 V.4.0'C 32°
774 V.4.0'C
TRACY VN.
LIT. DIAMOND VN.
DIAMOND VN.
610 V.3.0' DIRTY
ORCHARD VN.
610 V.6.6 C.4.0 35°
PRIMROSE VN.
610 V.11.0'C
HOLMES VN.
610 V.4.0 C.3.5
SAWMILL TRACT
BASE LINE 5000' SOUTH
SOUTH LINE OF ST. CLAIR LEASE
BASE LINE 0+00

LOOKING EAST

CROSS SECTION 40+00E

DATUM 400'
SCALE 1"=100'