


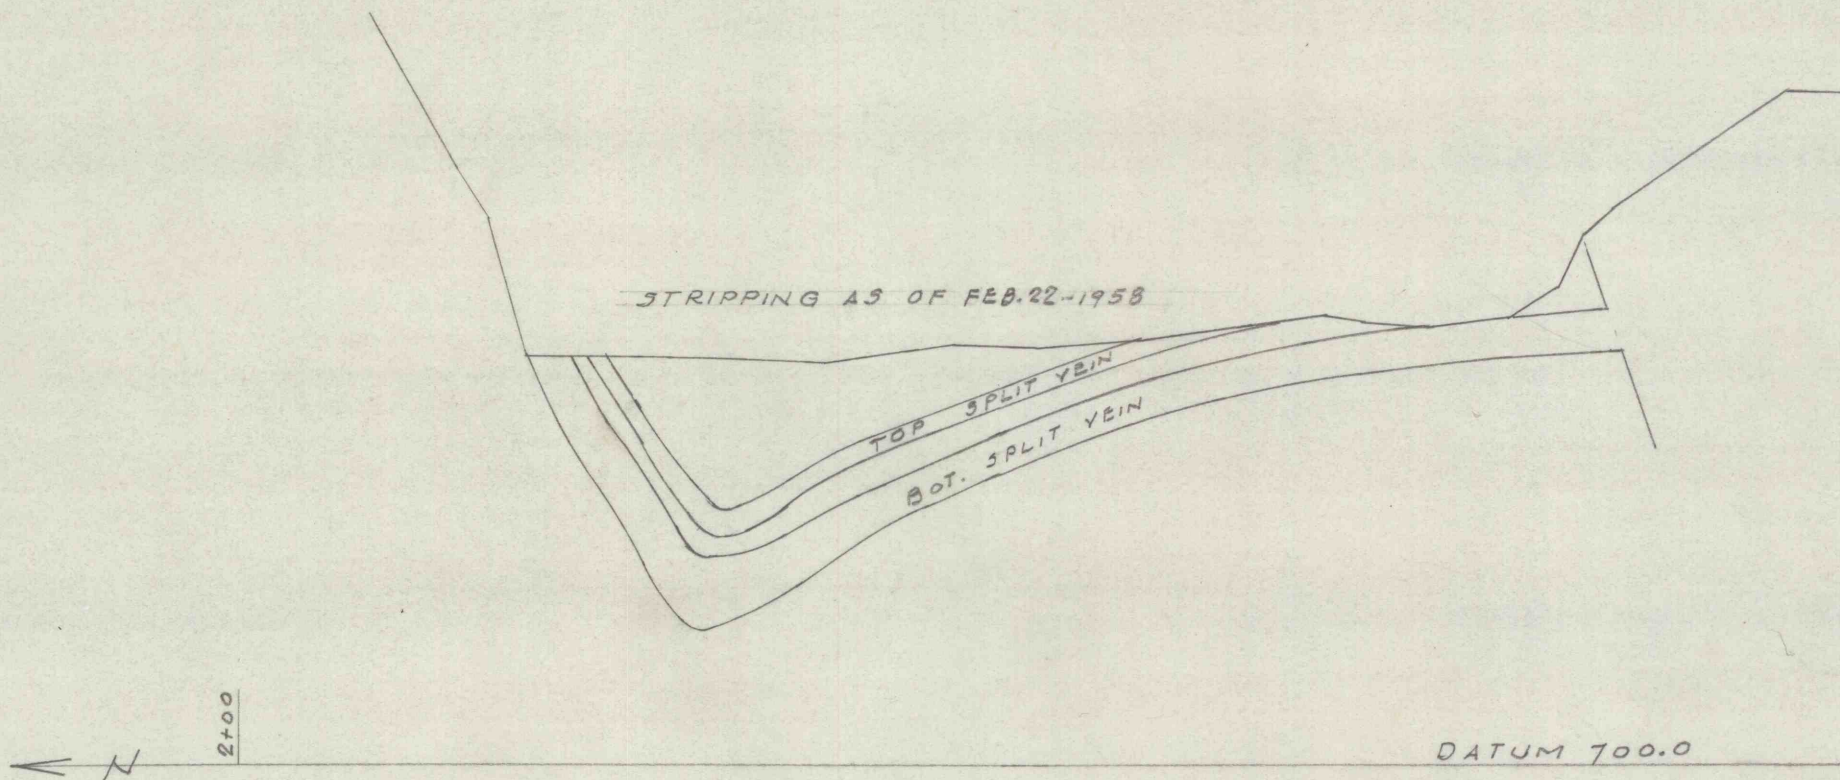

READING ANTHRACITE STRIPPING
SECTION 40+50
SCALE 1"=100' FEB. 19-1958