


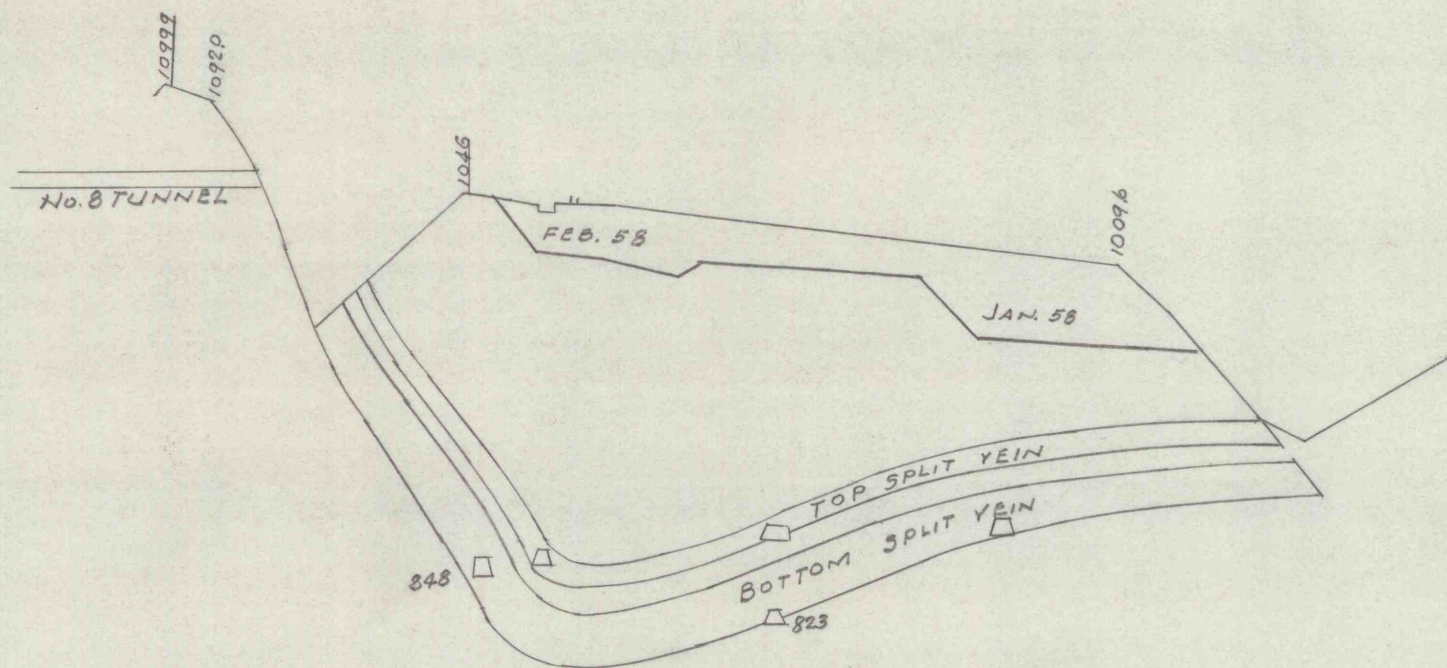

READING ANTHRACITE STRIPPING
NORTH BASIN
SECTION 44+00
SCALE 1"=100' 2-26-58