



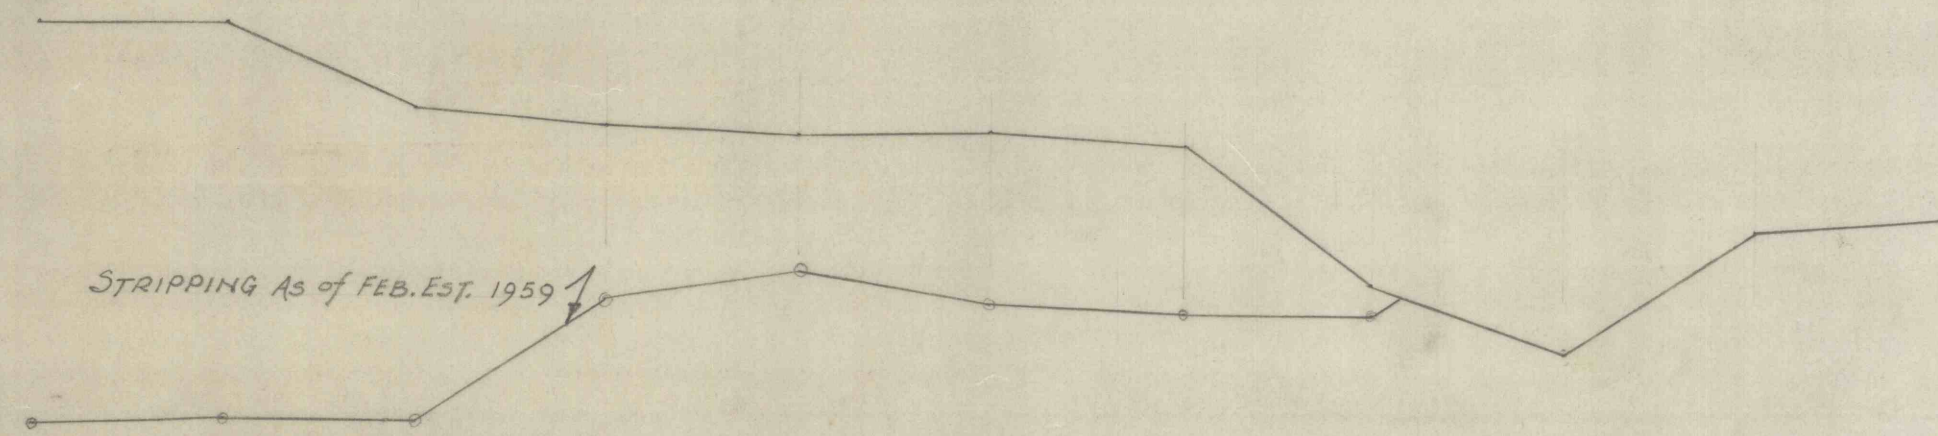

TOP SPLIT VEIN
BOTTOM SPLIT VEIN

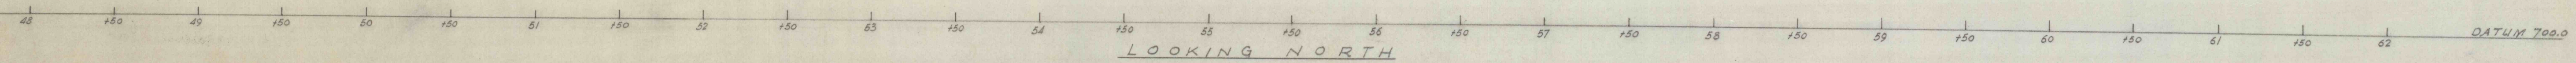

READING ANTHRACITE STRIPPING
NORTH BASIN
LONGITUDINAL SECTION THRU BASIN
SCALE 1"=50' 3-6-59