


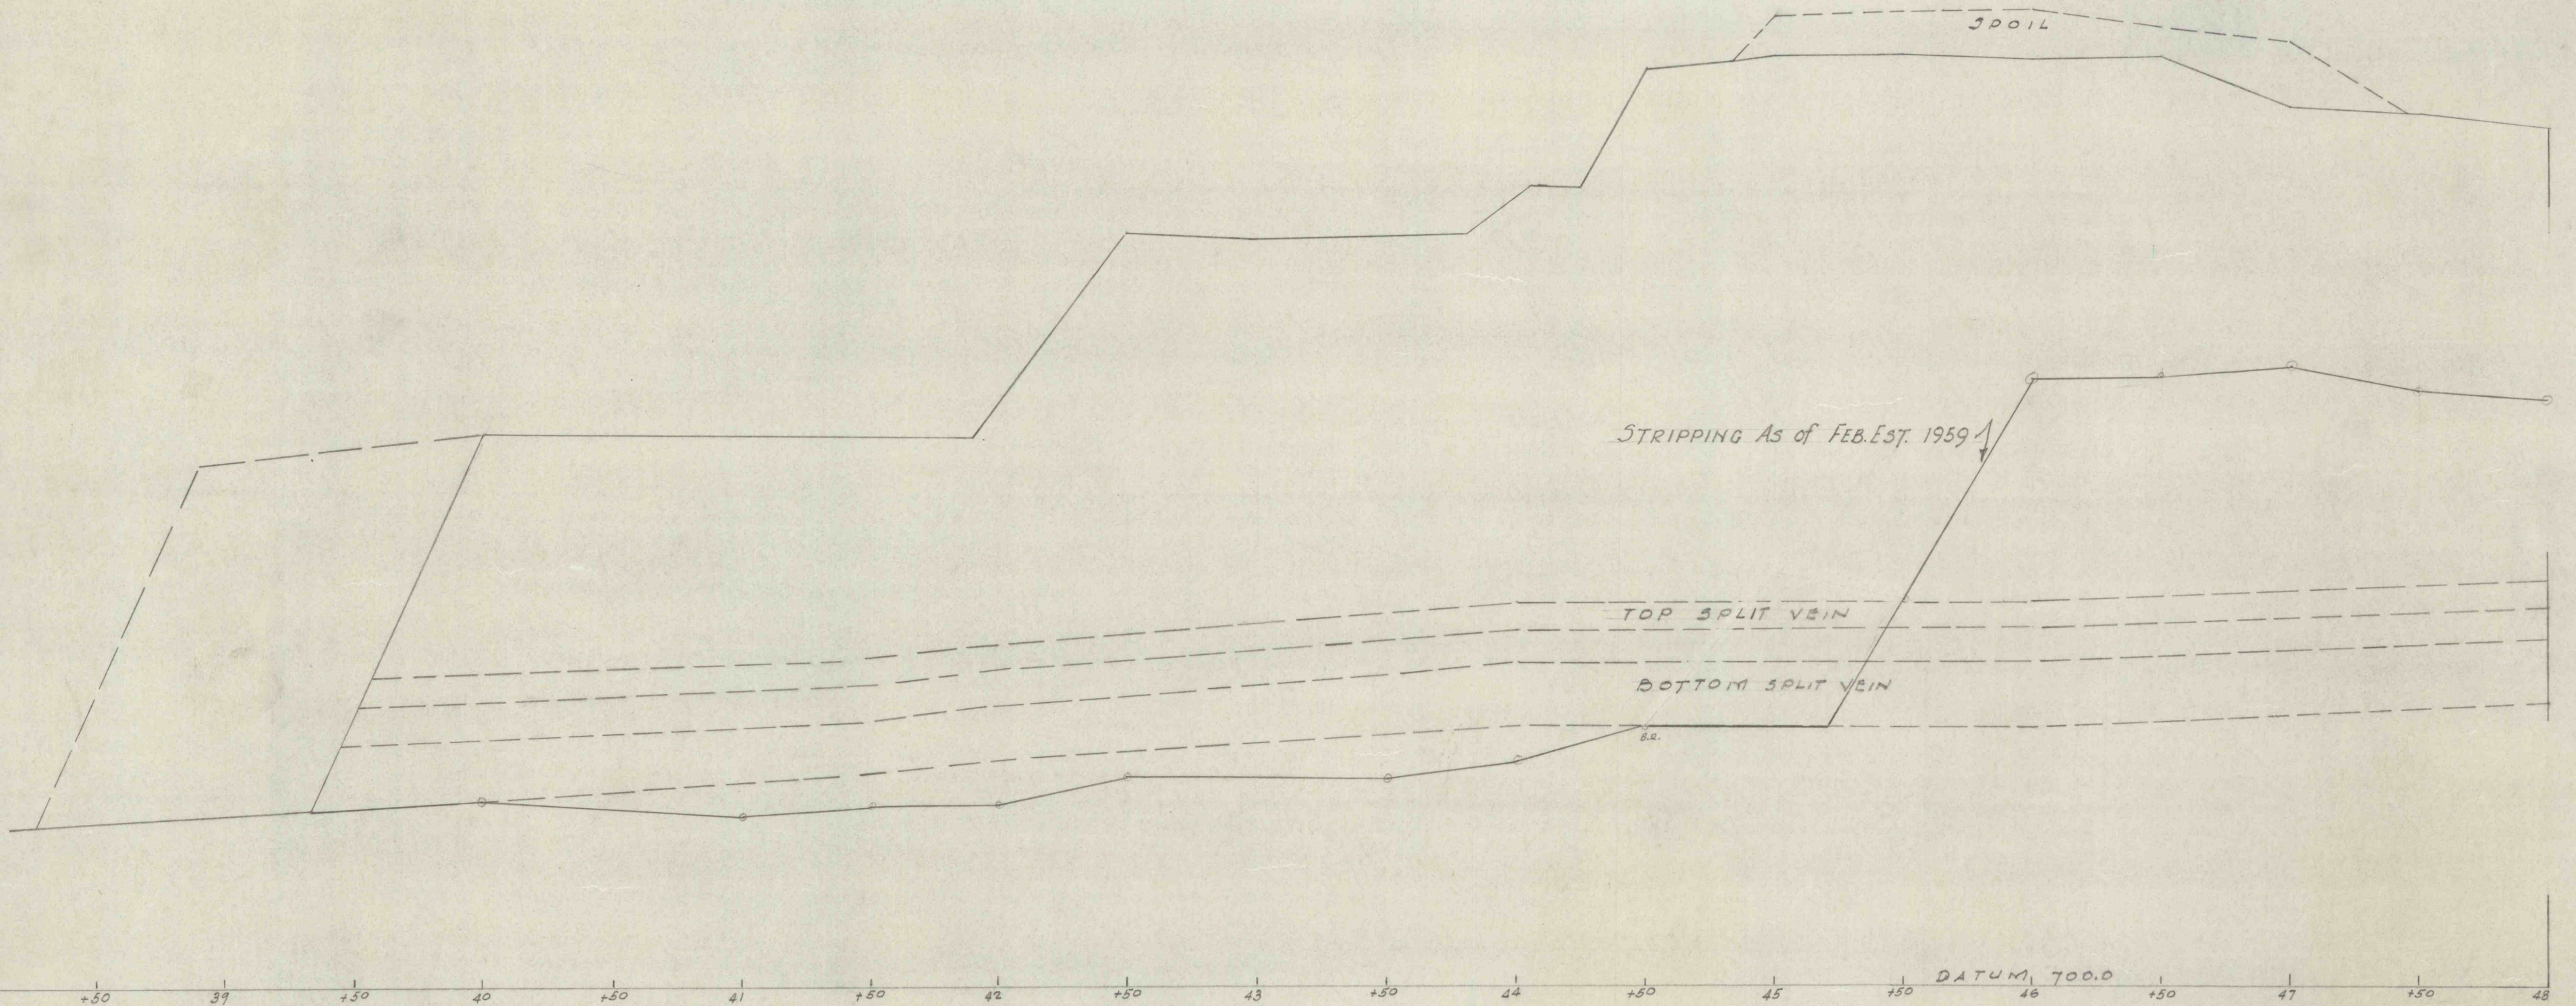

LOOKING NORTH

READING ANTHRACITE STRIPPING
NORTH BASIN
LONGITUDINAL SECTION THRU BASIN
SCALE 1"=50' 2-25-58