CROSS-SECTION

II { SILVER CREEK COLLIERY - THRU NO 3B TUNNEL NO 4 PLANE LEVEL
CEDAR HILL " - 1300 WEST OF MAIN SLOPE
EAGLE HILL " - 400 EAST OF NO 3 TUNNEL EAST
PALMER VEIN " - 1100 WEST OF MAIN SLOPE

SCALE 1"=100' - JULY 15 1921 - POTTSVILLE, PA.
G.A. ROOS, D.E.

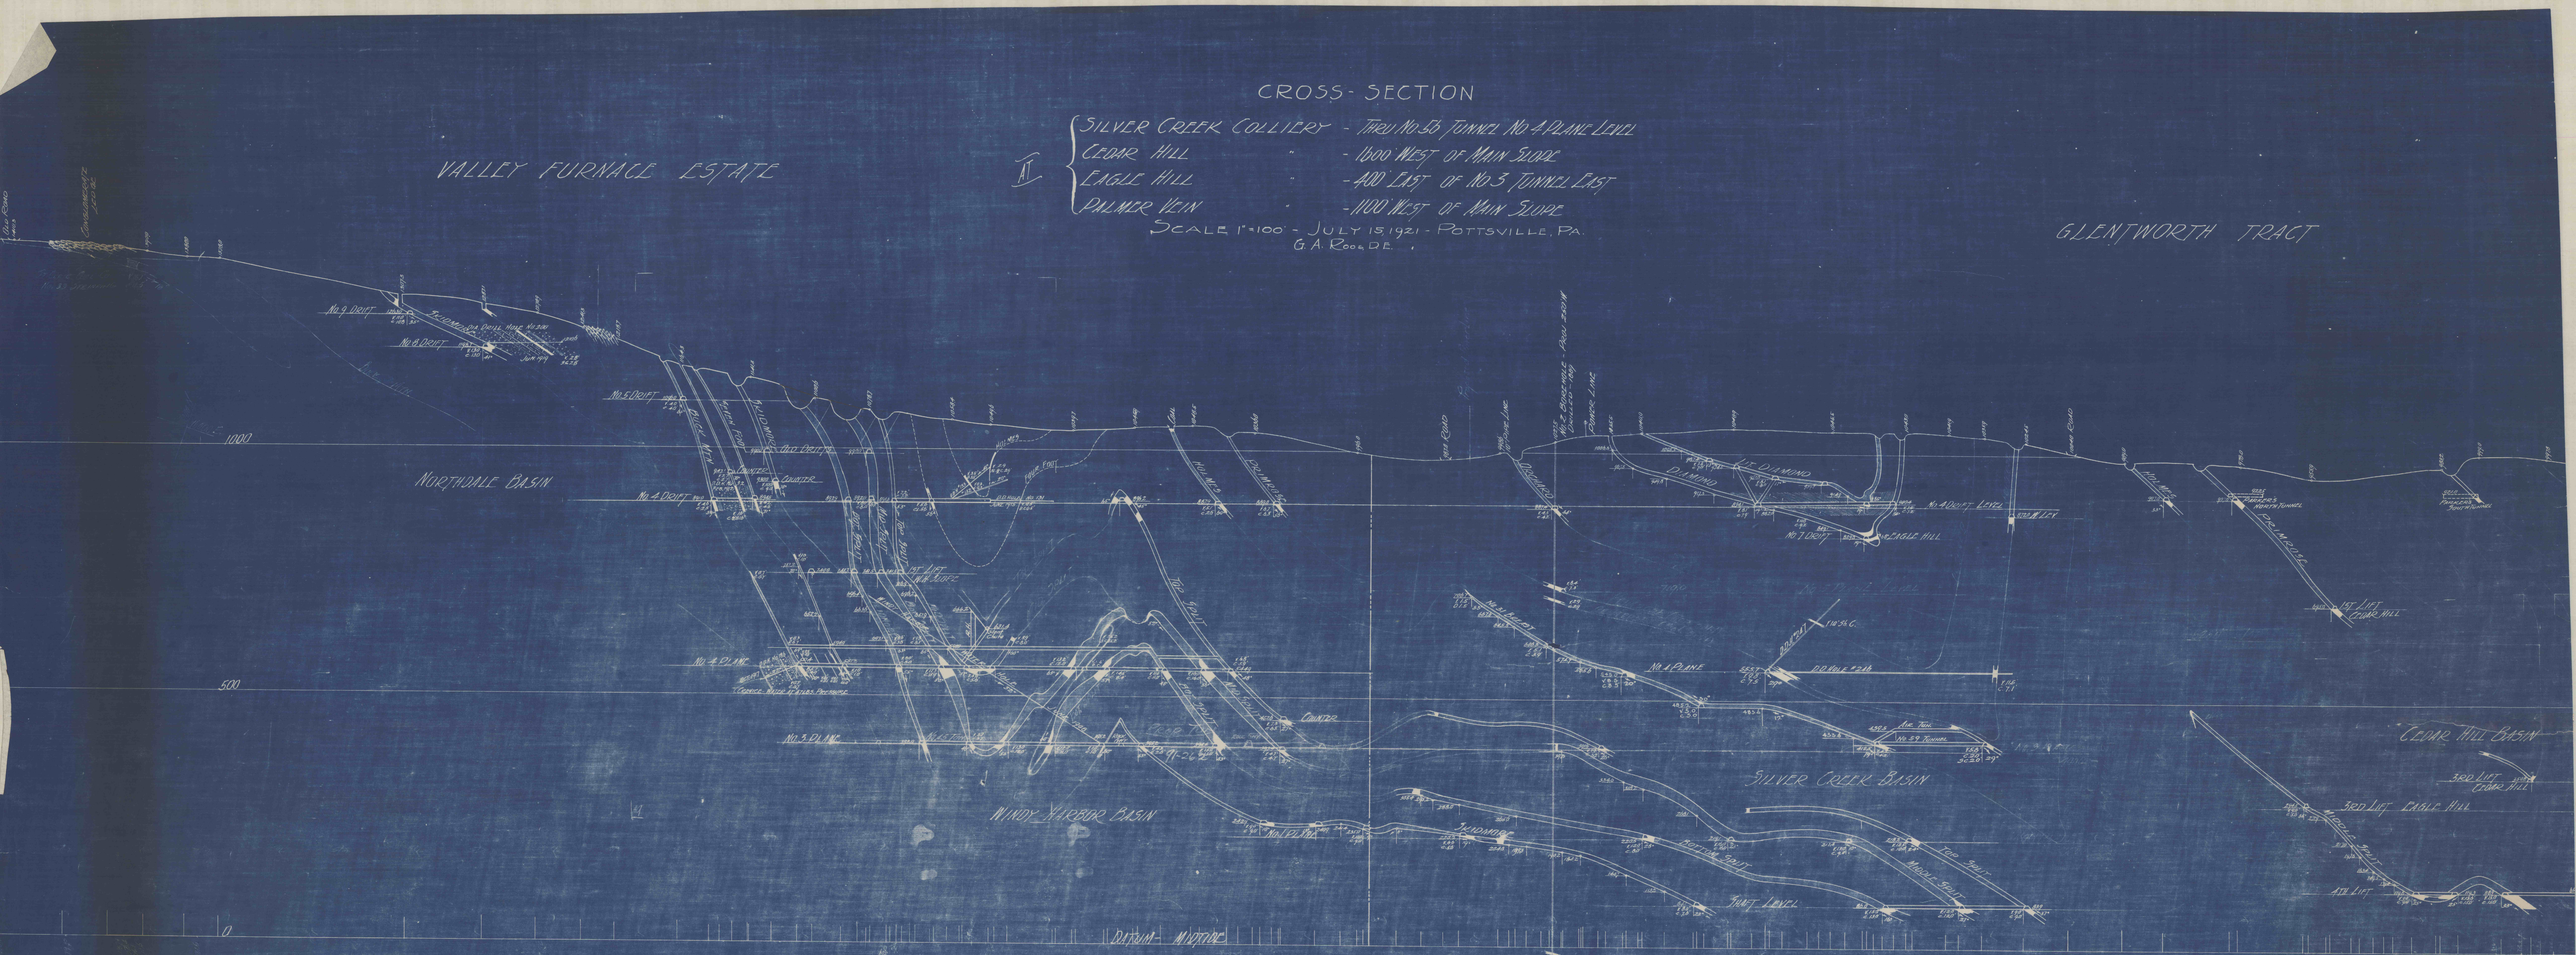

SECTION #9 - SCALE 1"=100'

9