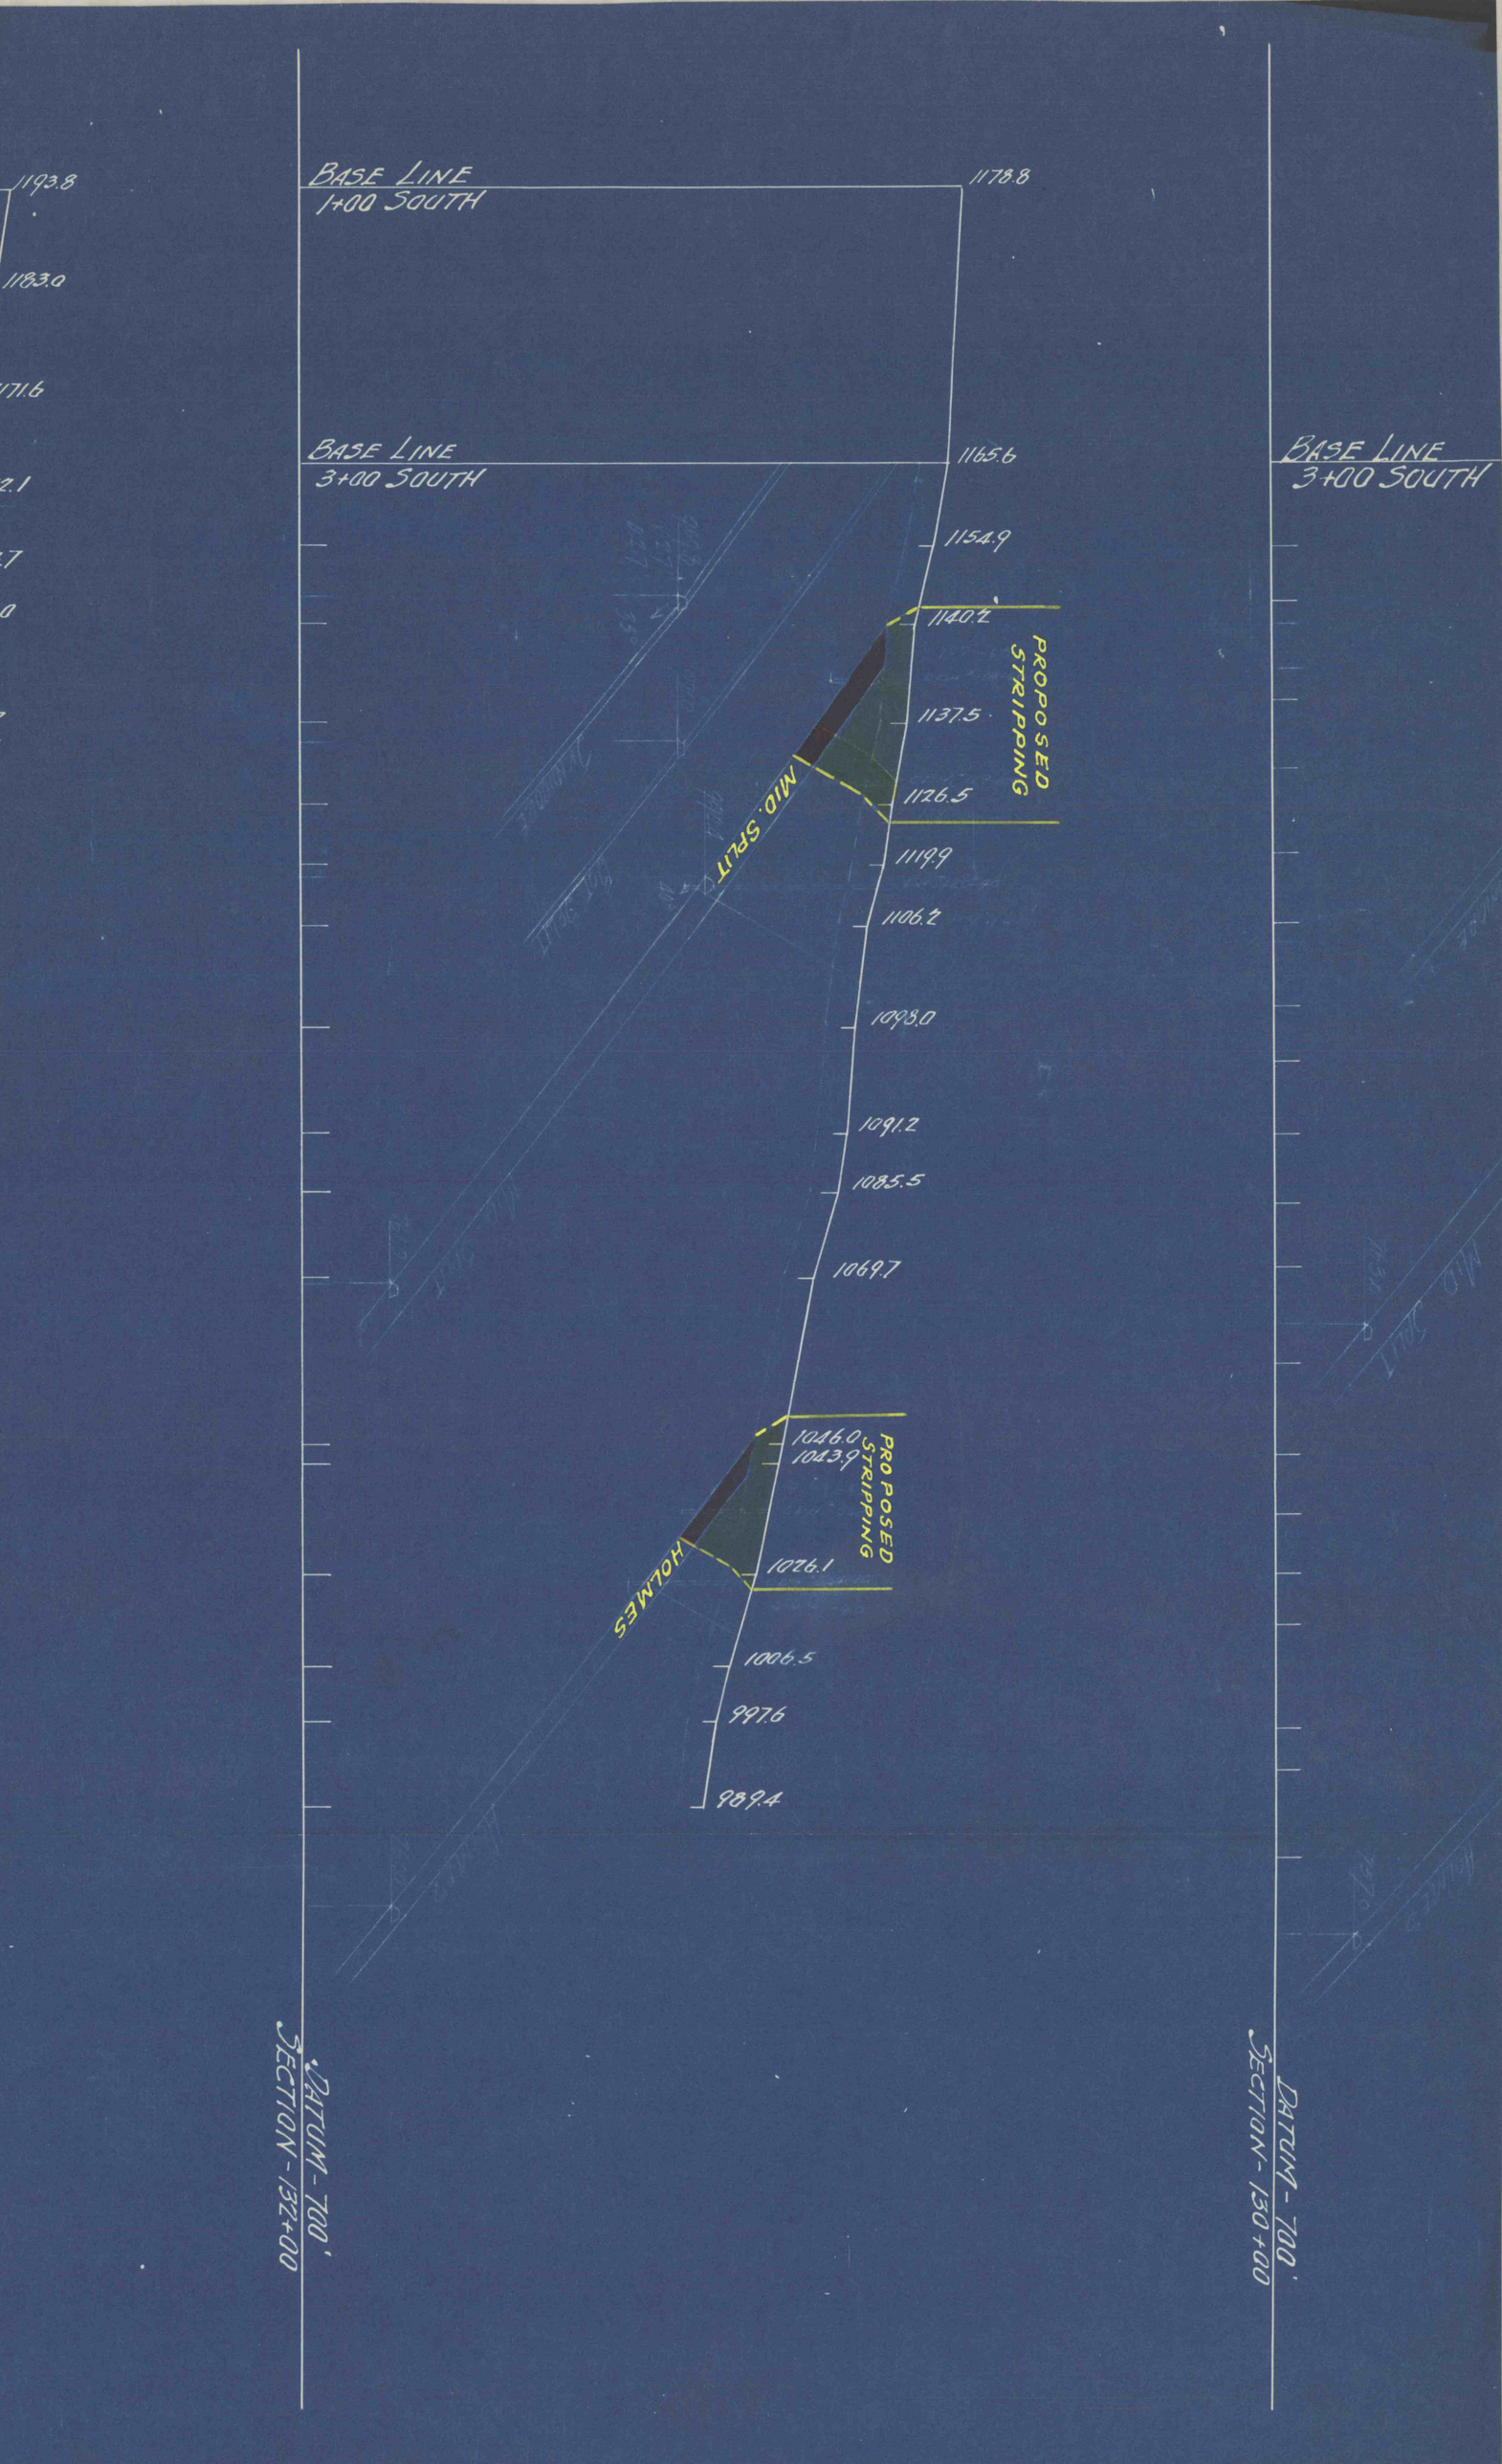
BASE LINE
1+00 SOUTH
1178.8
BASE LINE
3+00 SOUTH
1165.6
1154.9
1140.2
PROPOSED STRIPPING
1137.5
1126.5
MID. SPLIT
1119.9
1106.2
1093.0
1091.2
1085.5
1069.7
1046.0
1043.9
PROPOSED STRIPPING
HOLMES
1026.1
1006.5
997.6
989.4
DATUM - 700'
SECTION - 132+00
DATUM - 700'
SECTION - 130+00