


BASE LINE
5+00 SOUTH

DATUM - 700'
SECTION 107 - 108+00

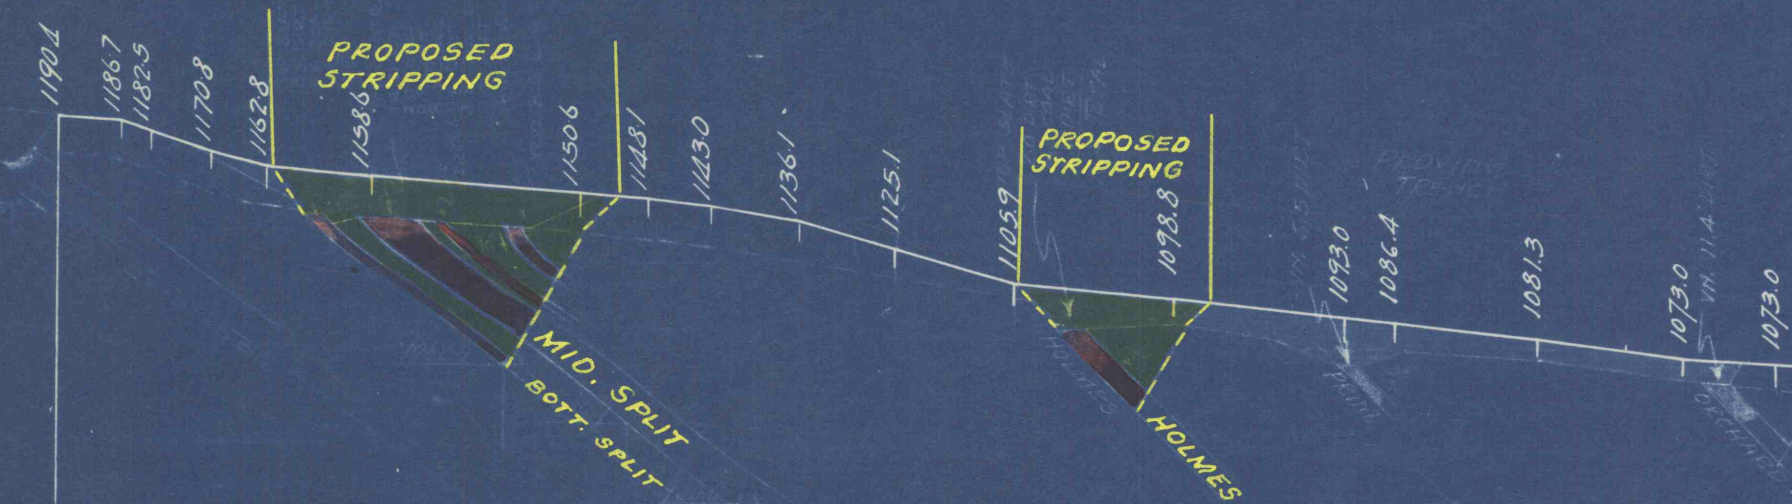

BASE LINE
5+00 SOUTH

DATUM - 700'
SECTION 107 - 110+00