


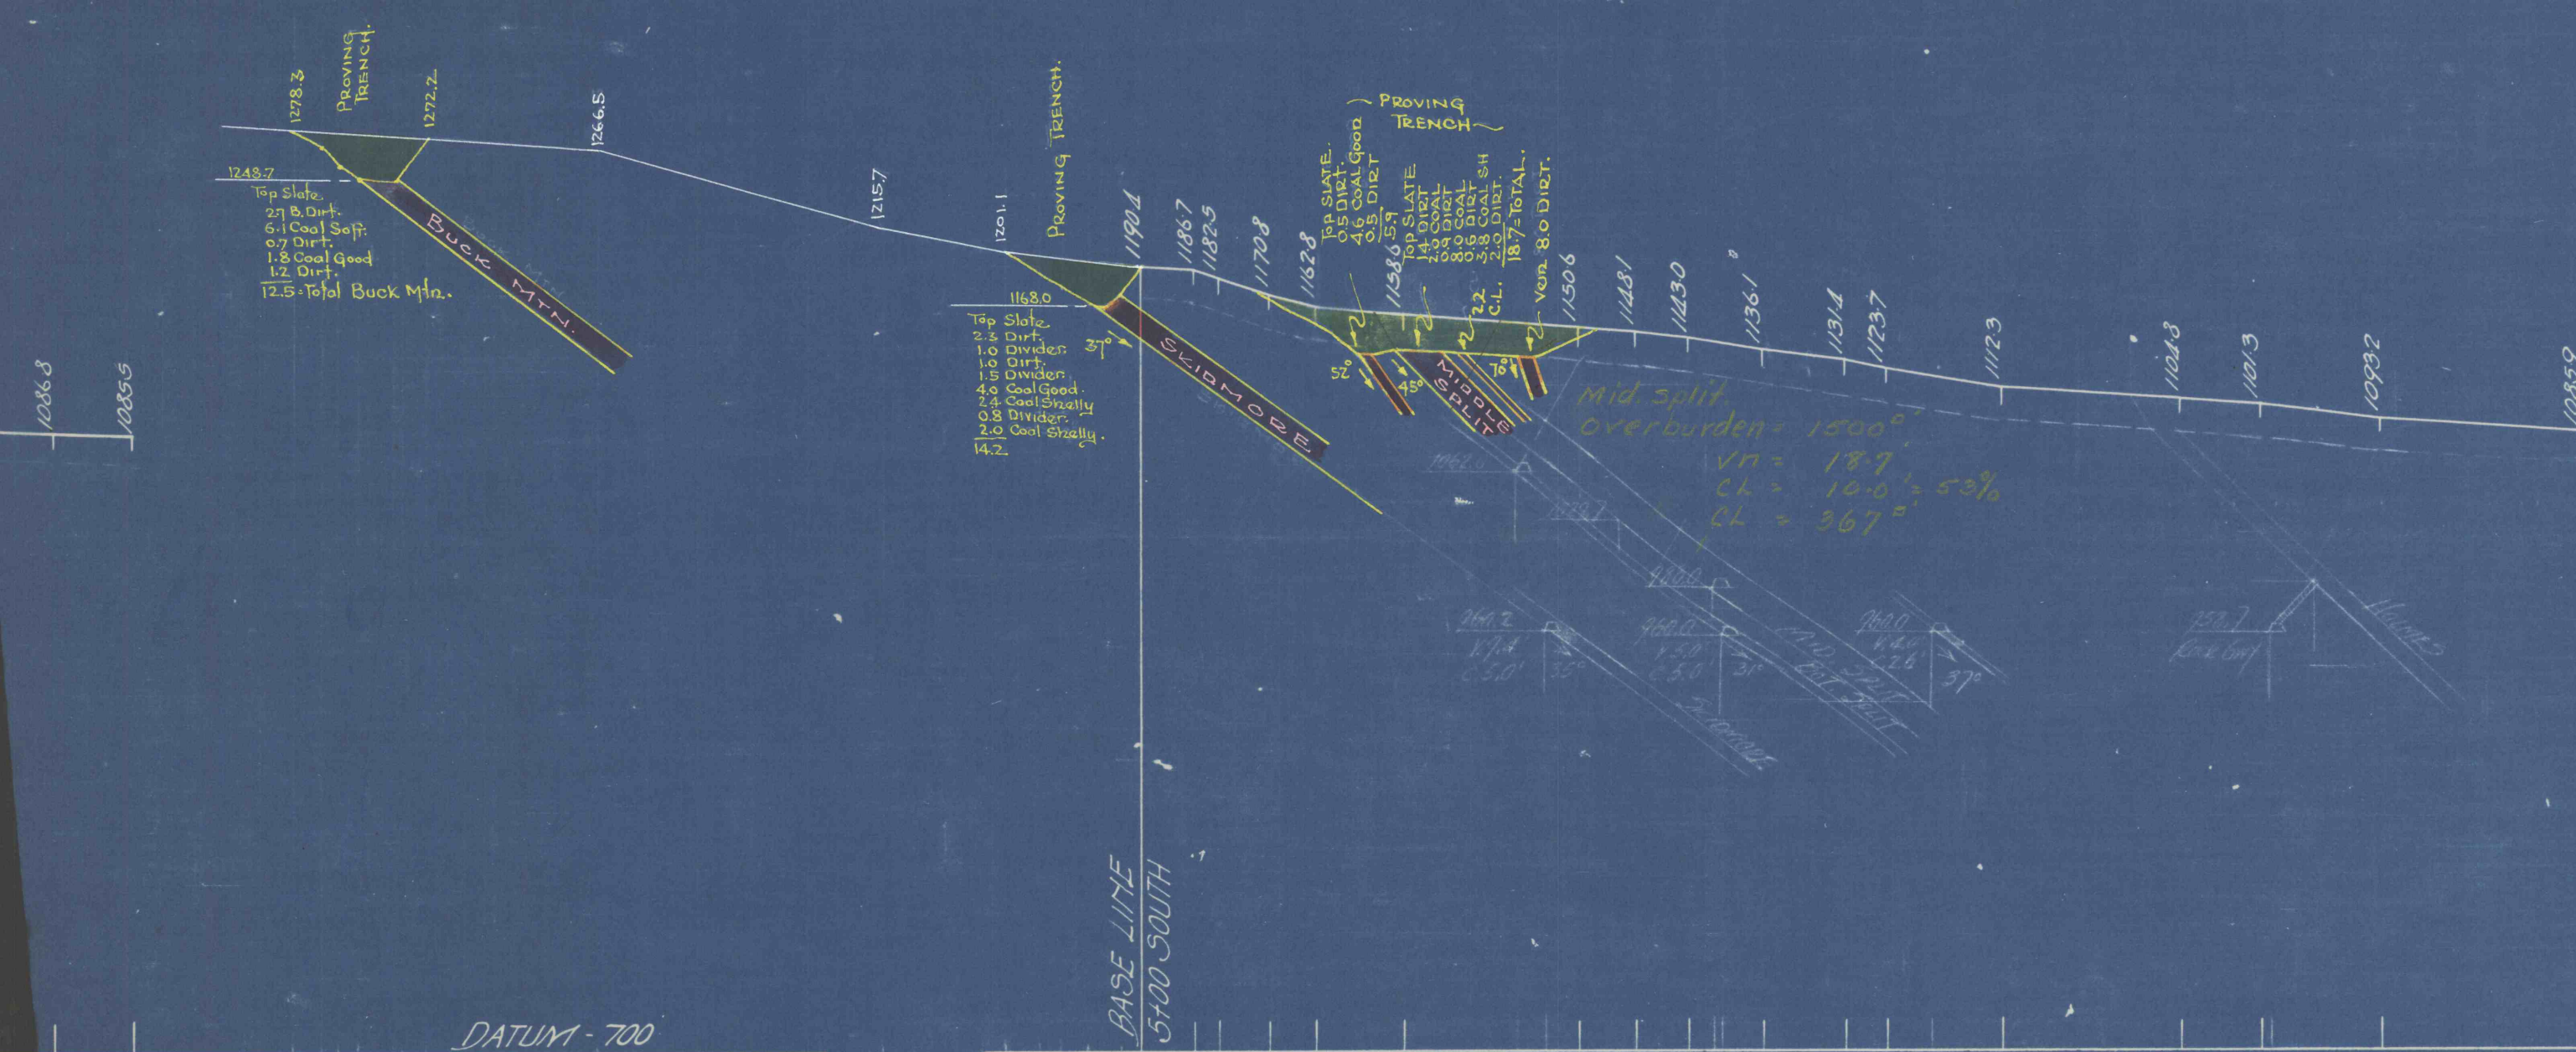

DATUM - 700
SECTION - 102+00

DATUM - 700
SECTION - 110+00