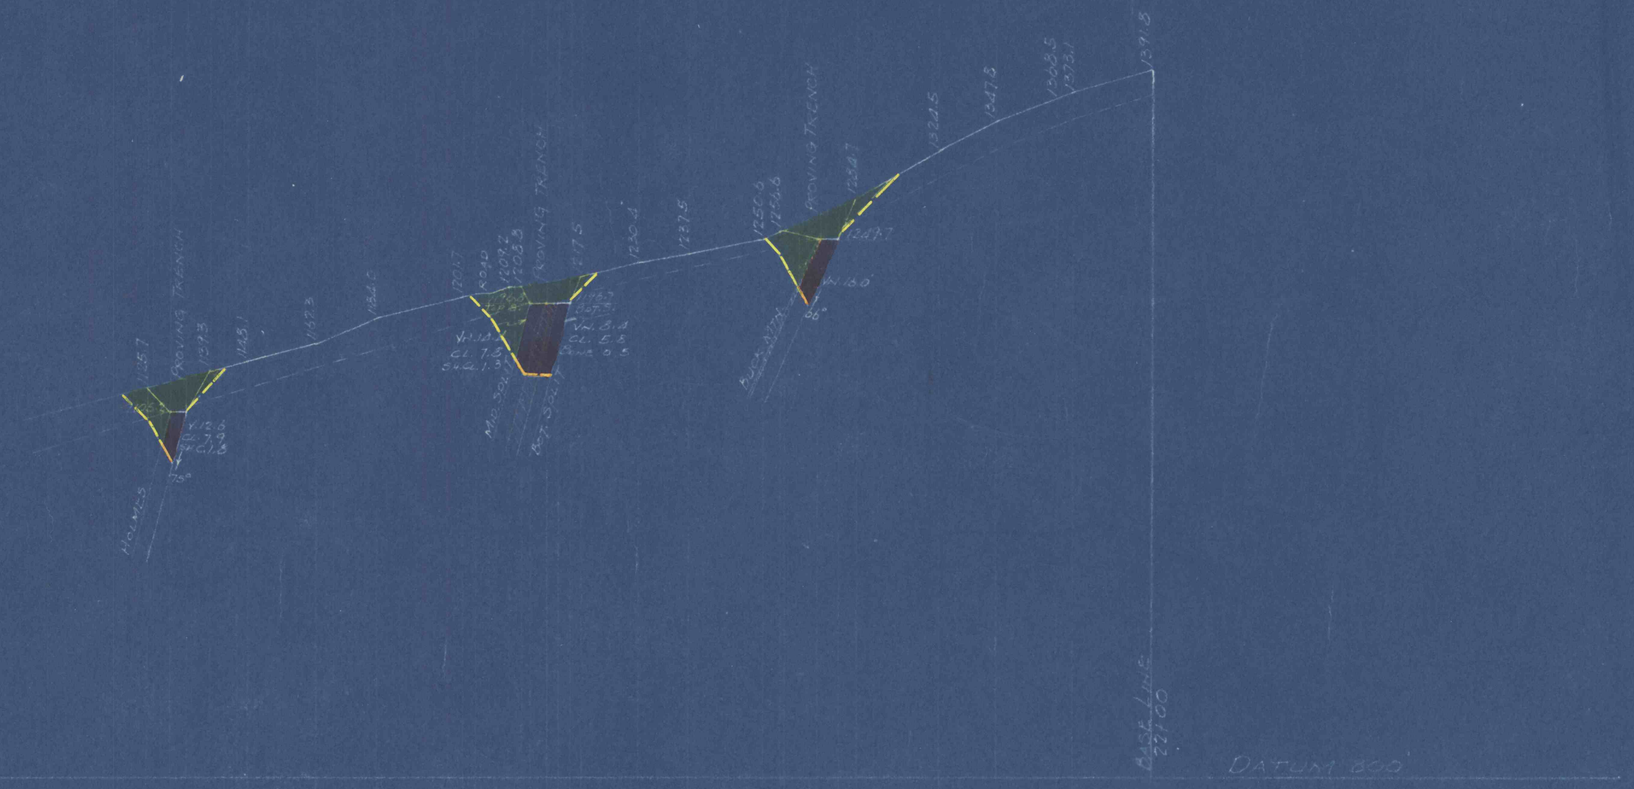


REVISED 11-5-60 (J.J.)
SECT. 22+00 ON SHARP MOUNTAIN
SHOWING PROVINGS
JUNE 15 1960 SCALE 1"=100