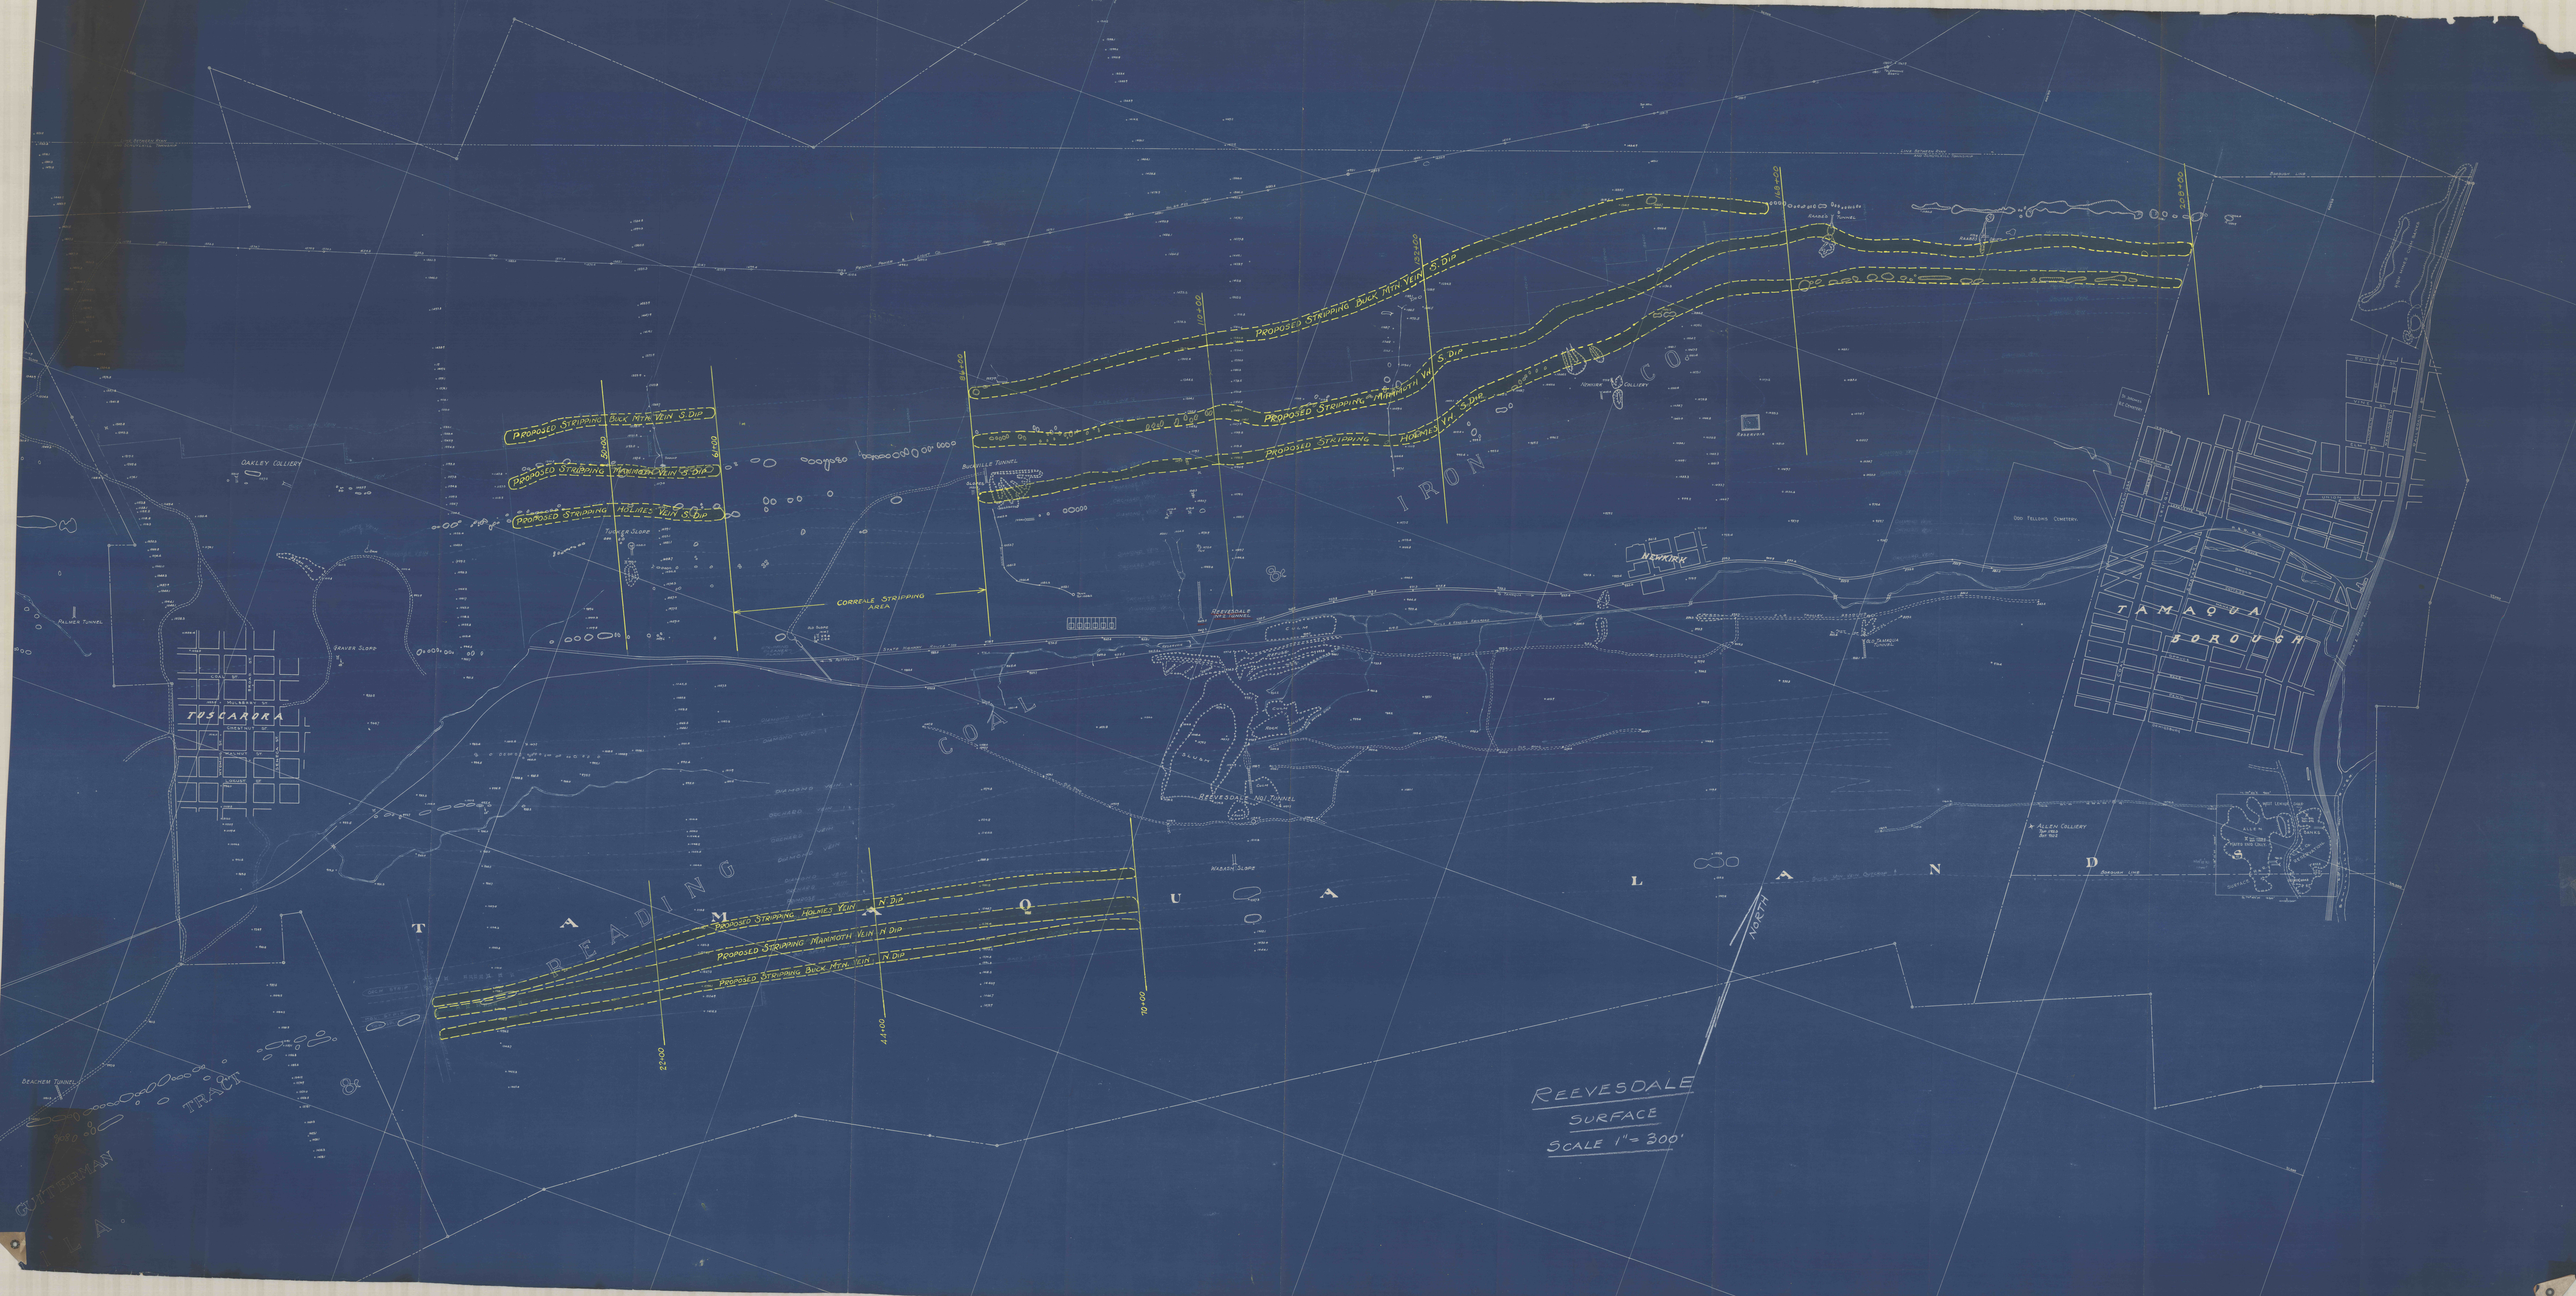
PROPOSED STRIPPING BUCK MTN VEIN S. DIP
PROPOSED STRIPPING MAMMOTH VEIN S. DIP
PROPOSED STRIPPING HOLMES VEIN S. DIP
PROPOSED STRIPPING BUCK MTN VEIN N. DIP
PROPOSED STRIPPING MAMMOTH VEIN N. DIP
PROPOSED STRIPPING HOLMES VEIN N. DIP
CORRELE STRIPPING AREA
OAKLEY COLLIERY
TUSCARORA
TAMAQUA BOROUGH
READING COAL & IRON CO.
TAMAQUA & LAND
NORTH
REEVESDALE
SURFACE
SCALE 1" = 300'