


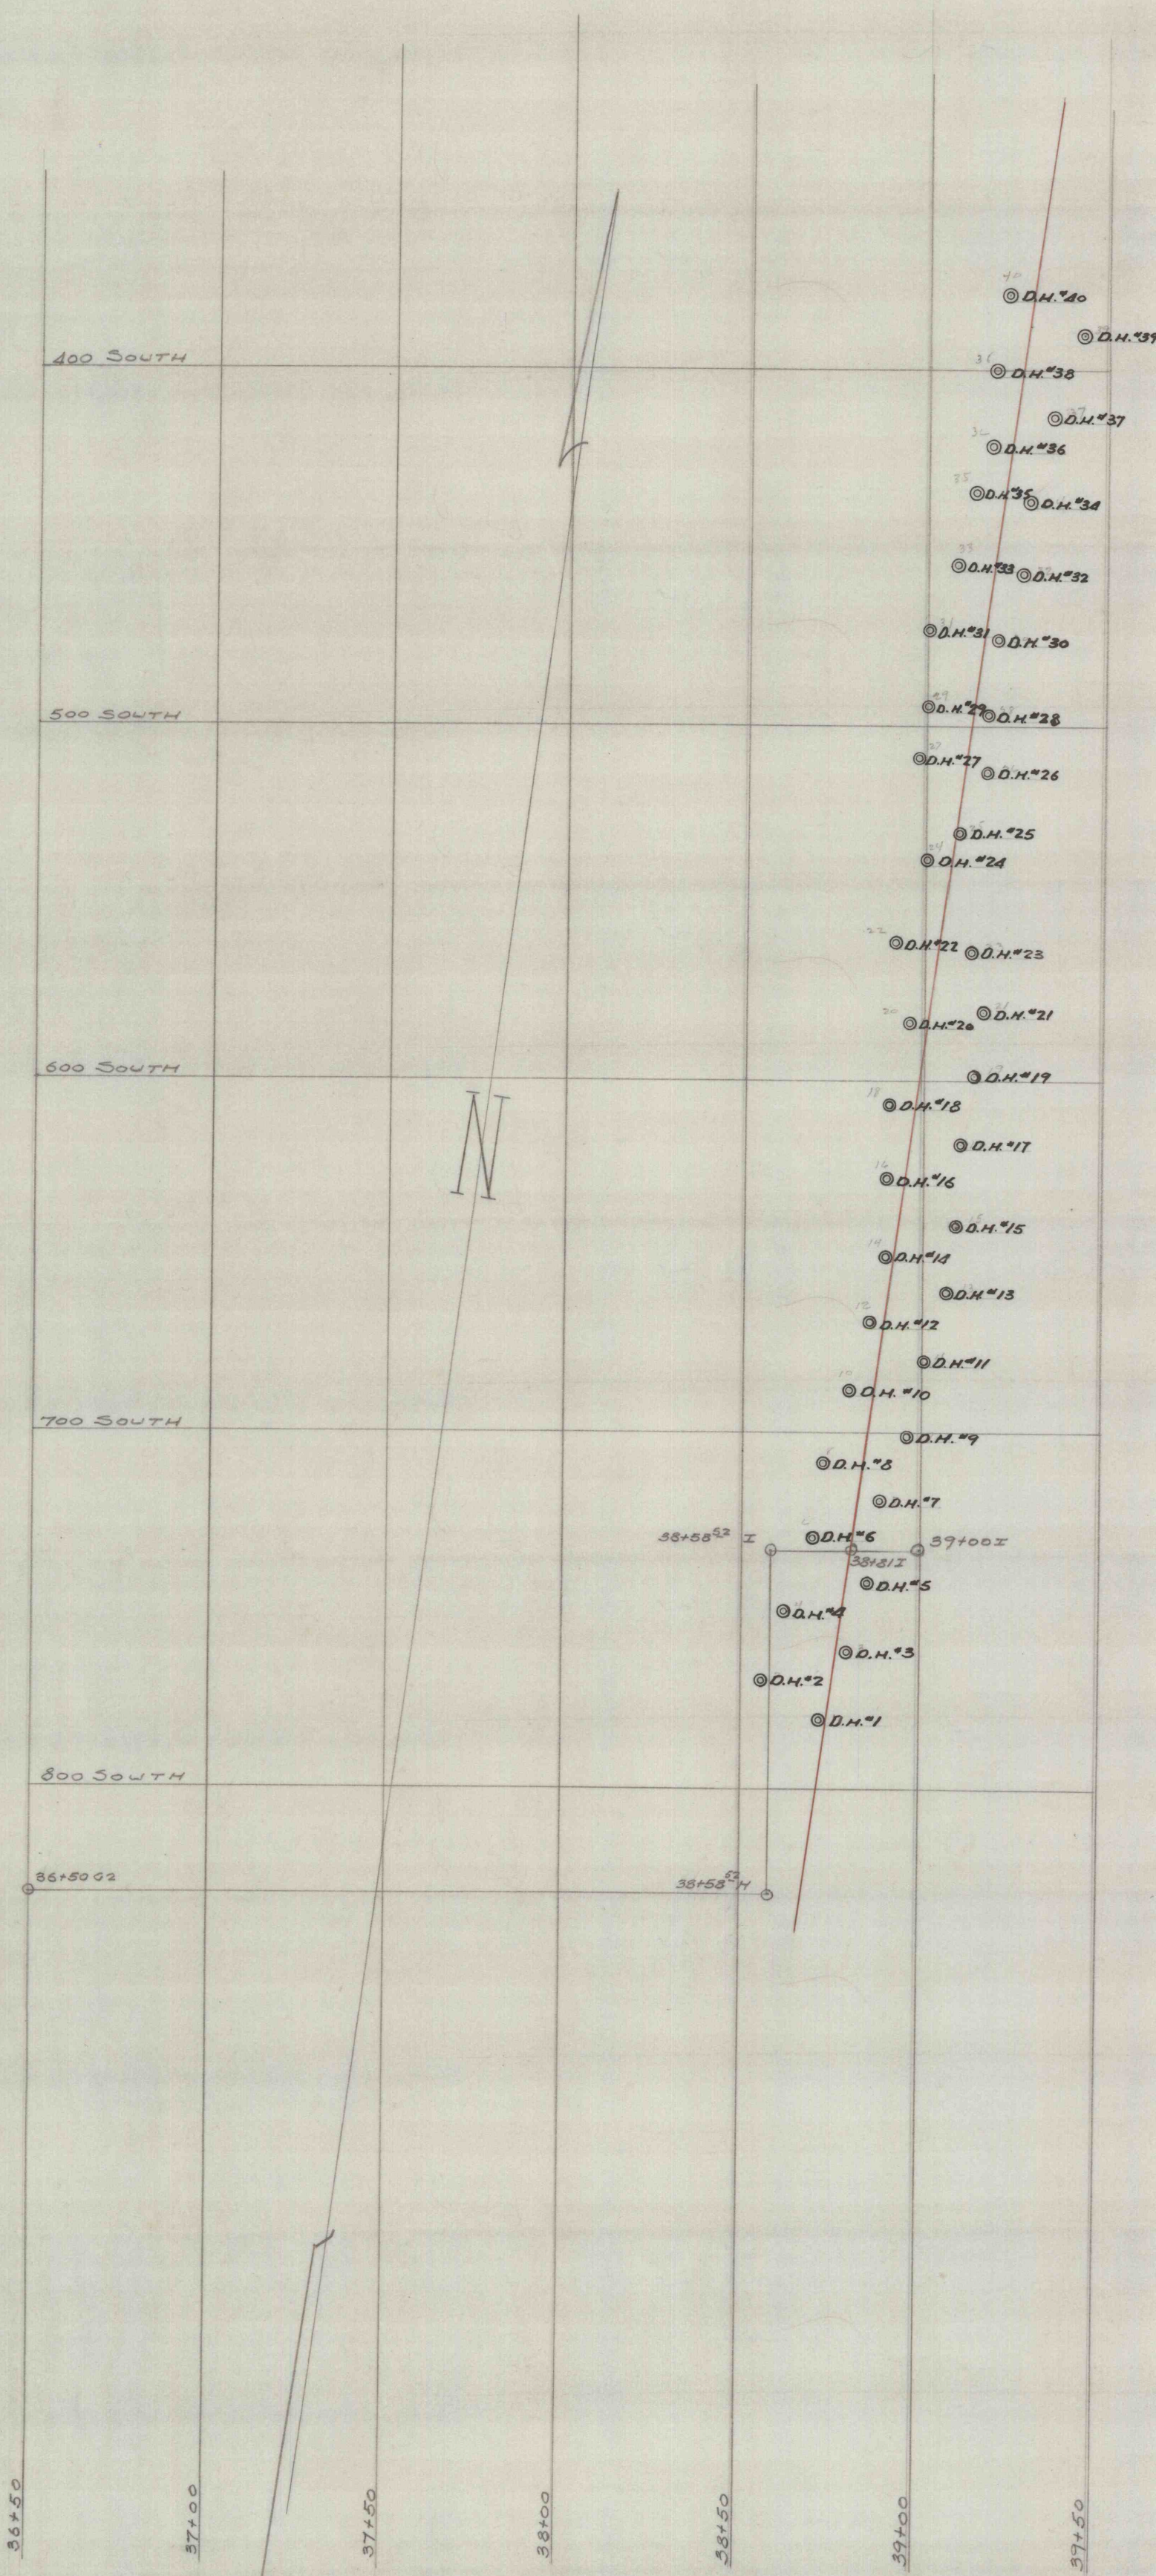

READING ANTHRACITE

June 8, 1957 Scale 1"=40'