


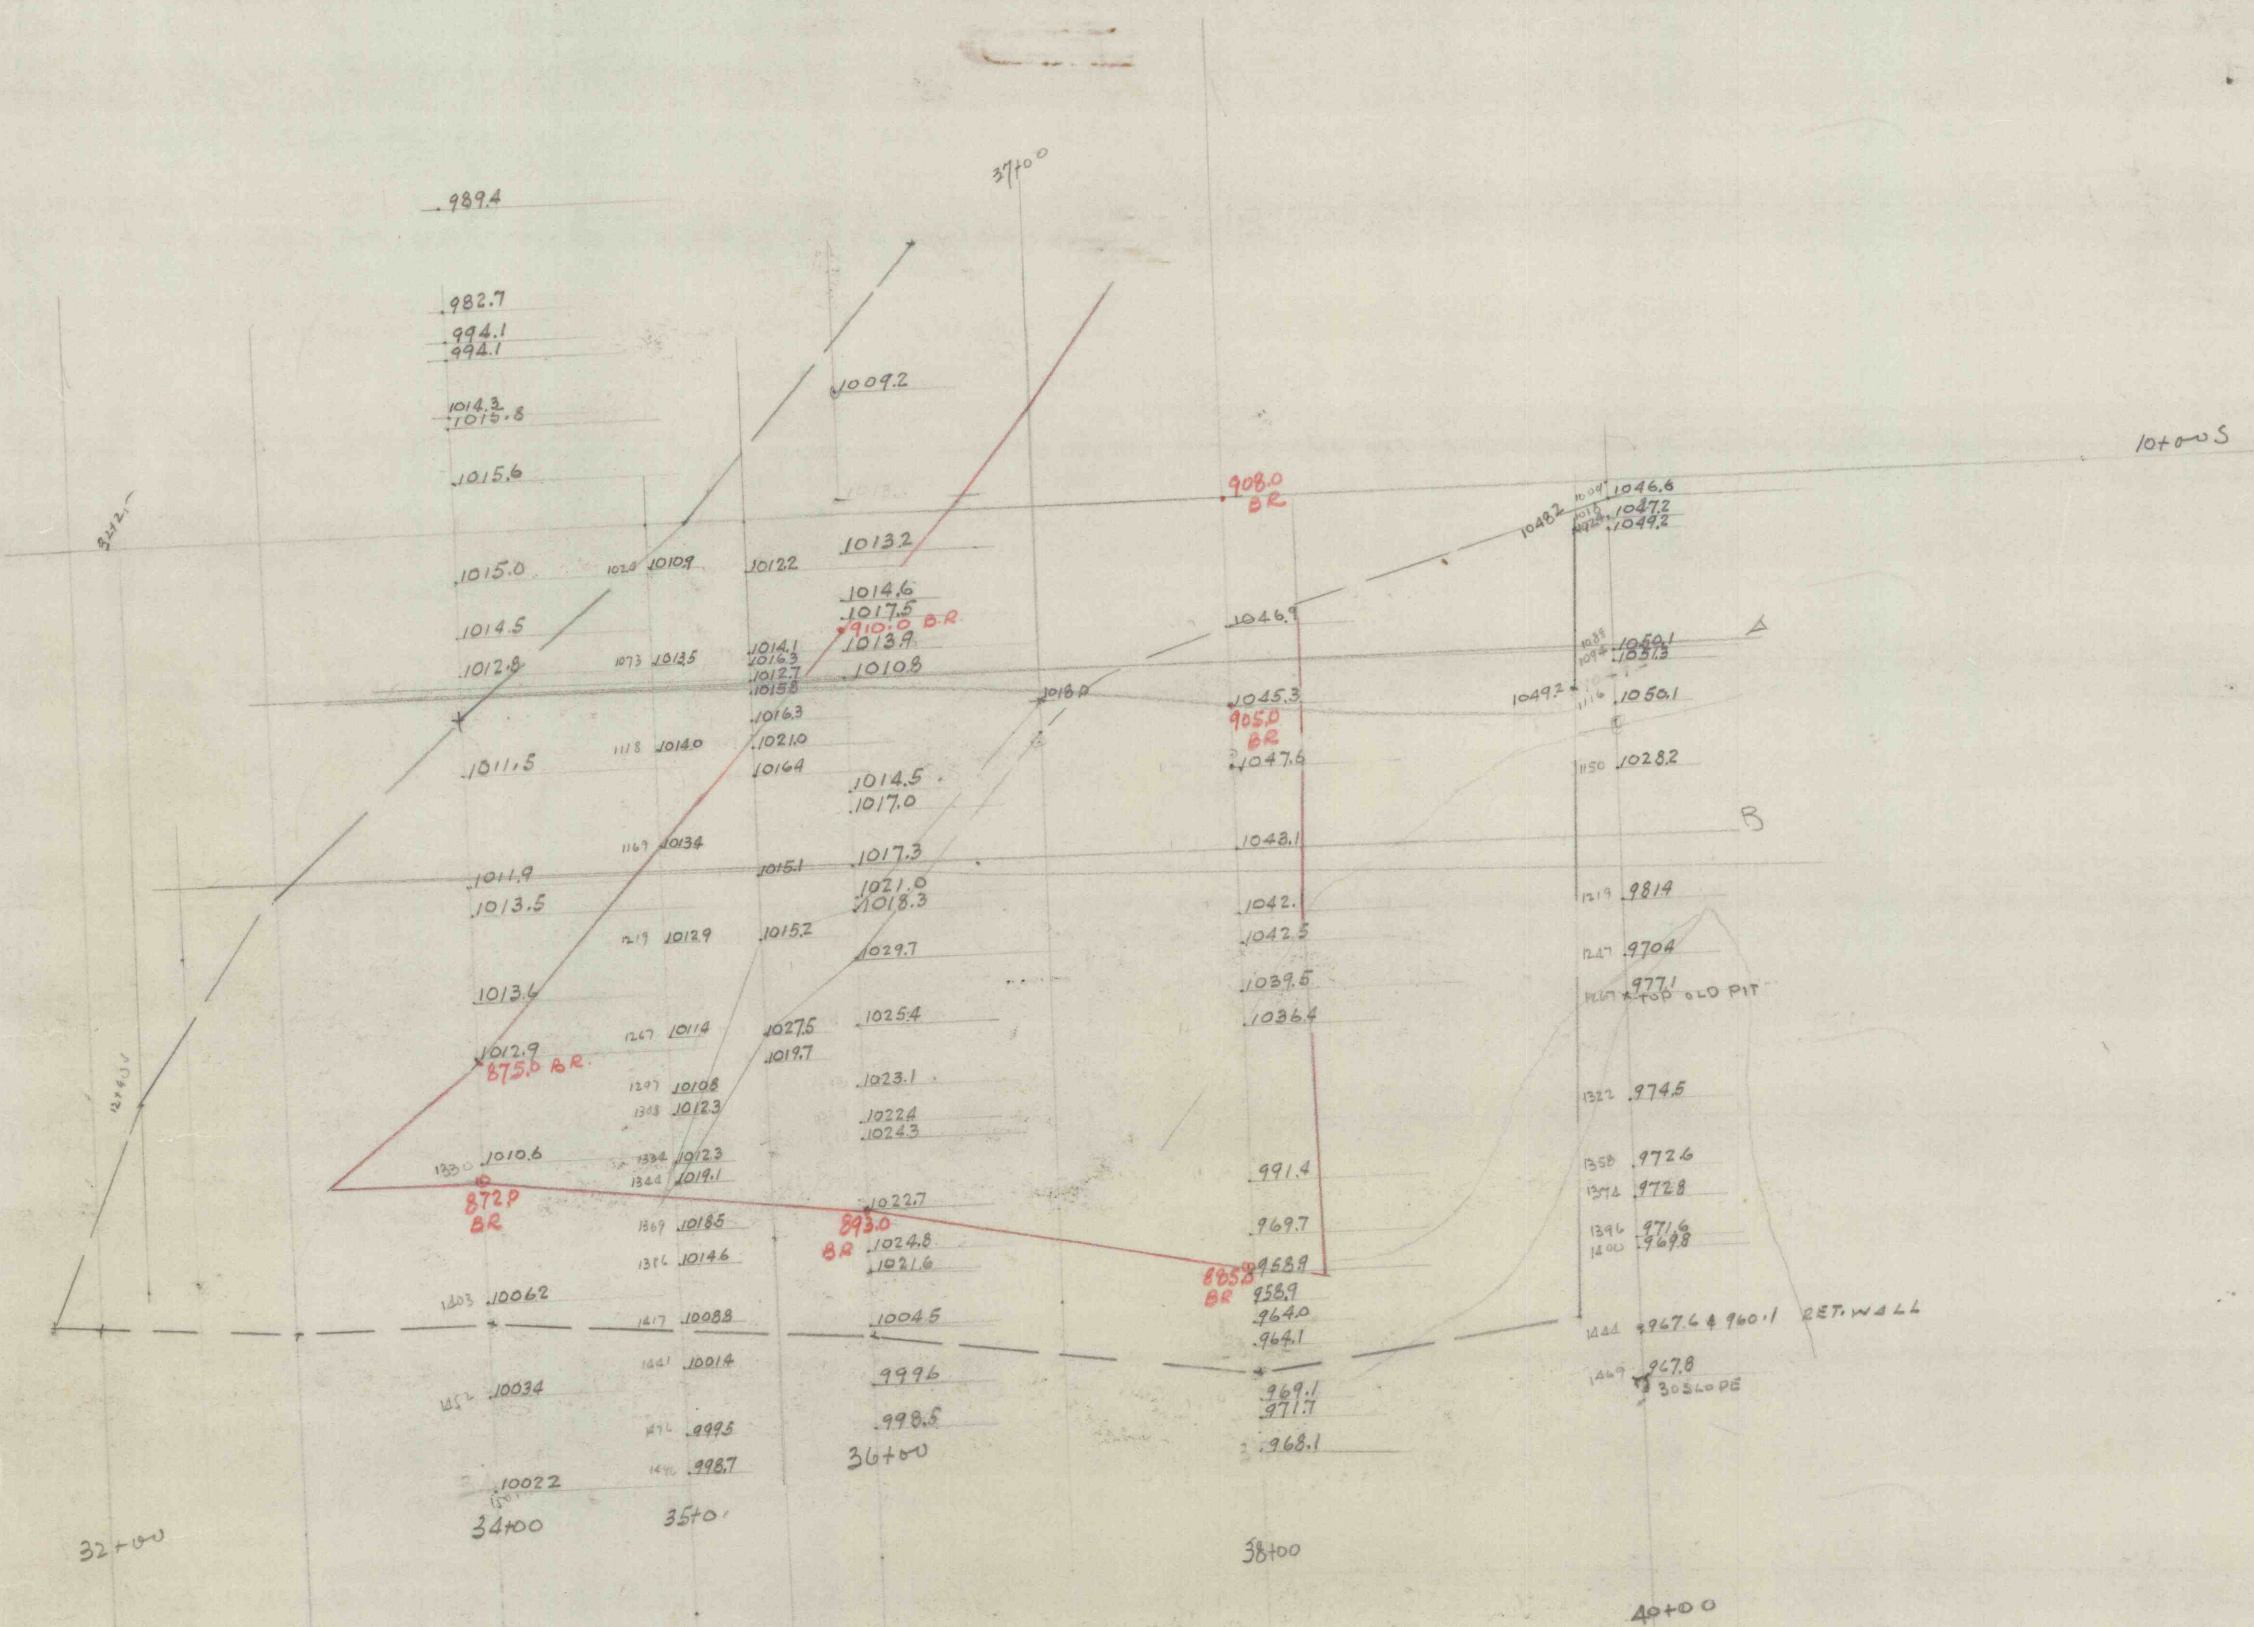

READING ANTHRACITE
#83 STRIPPING
1"=100

2000-MT-JAT