


ES2

ES2

C100-MT-JAT

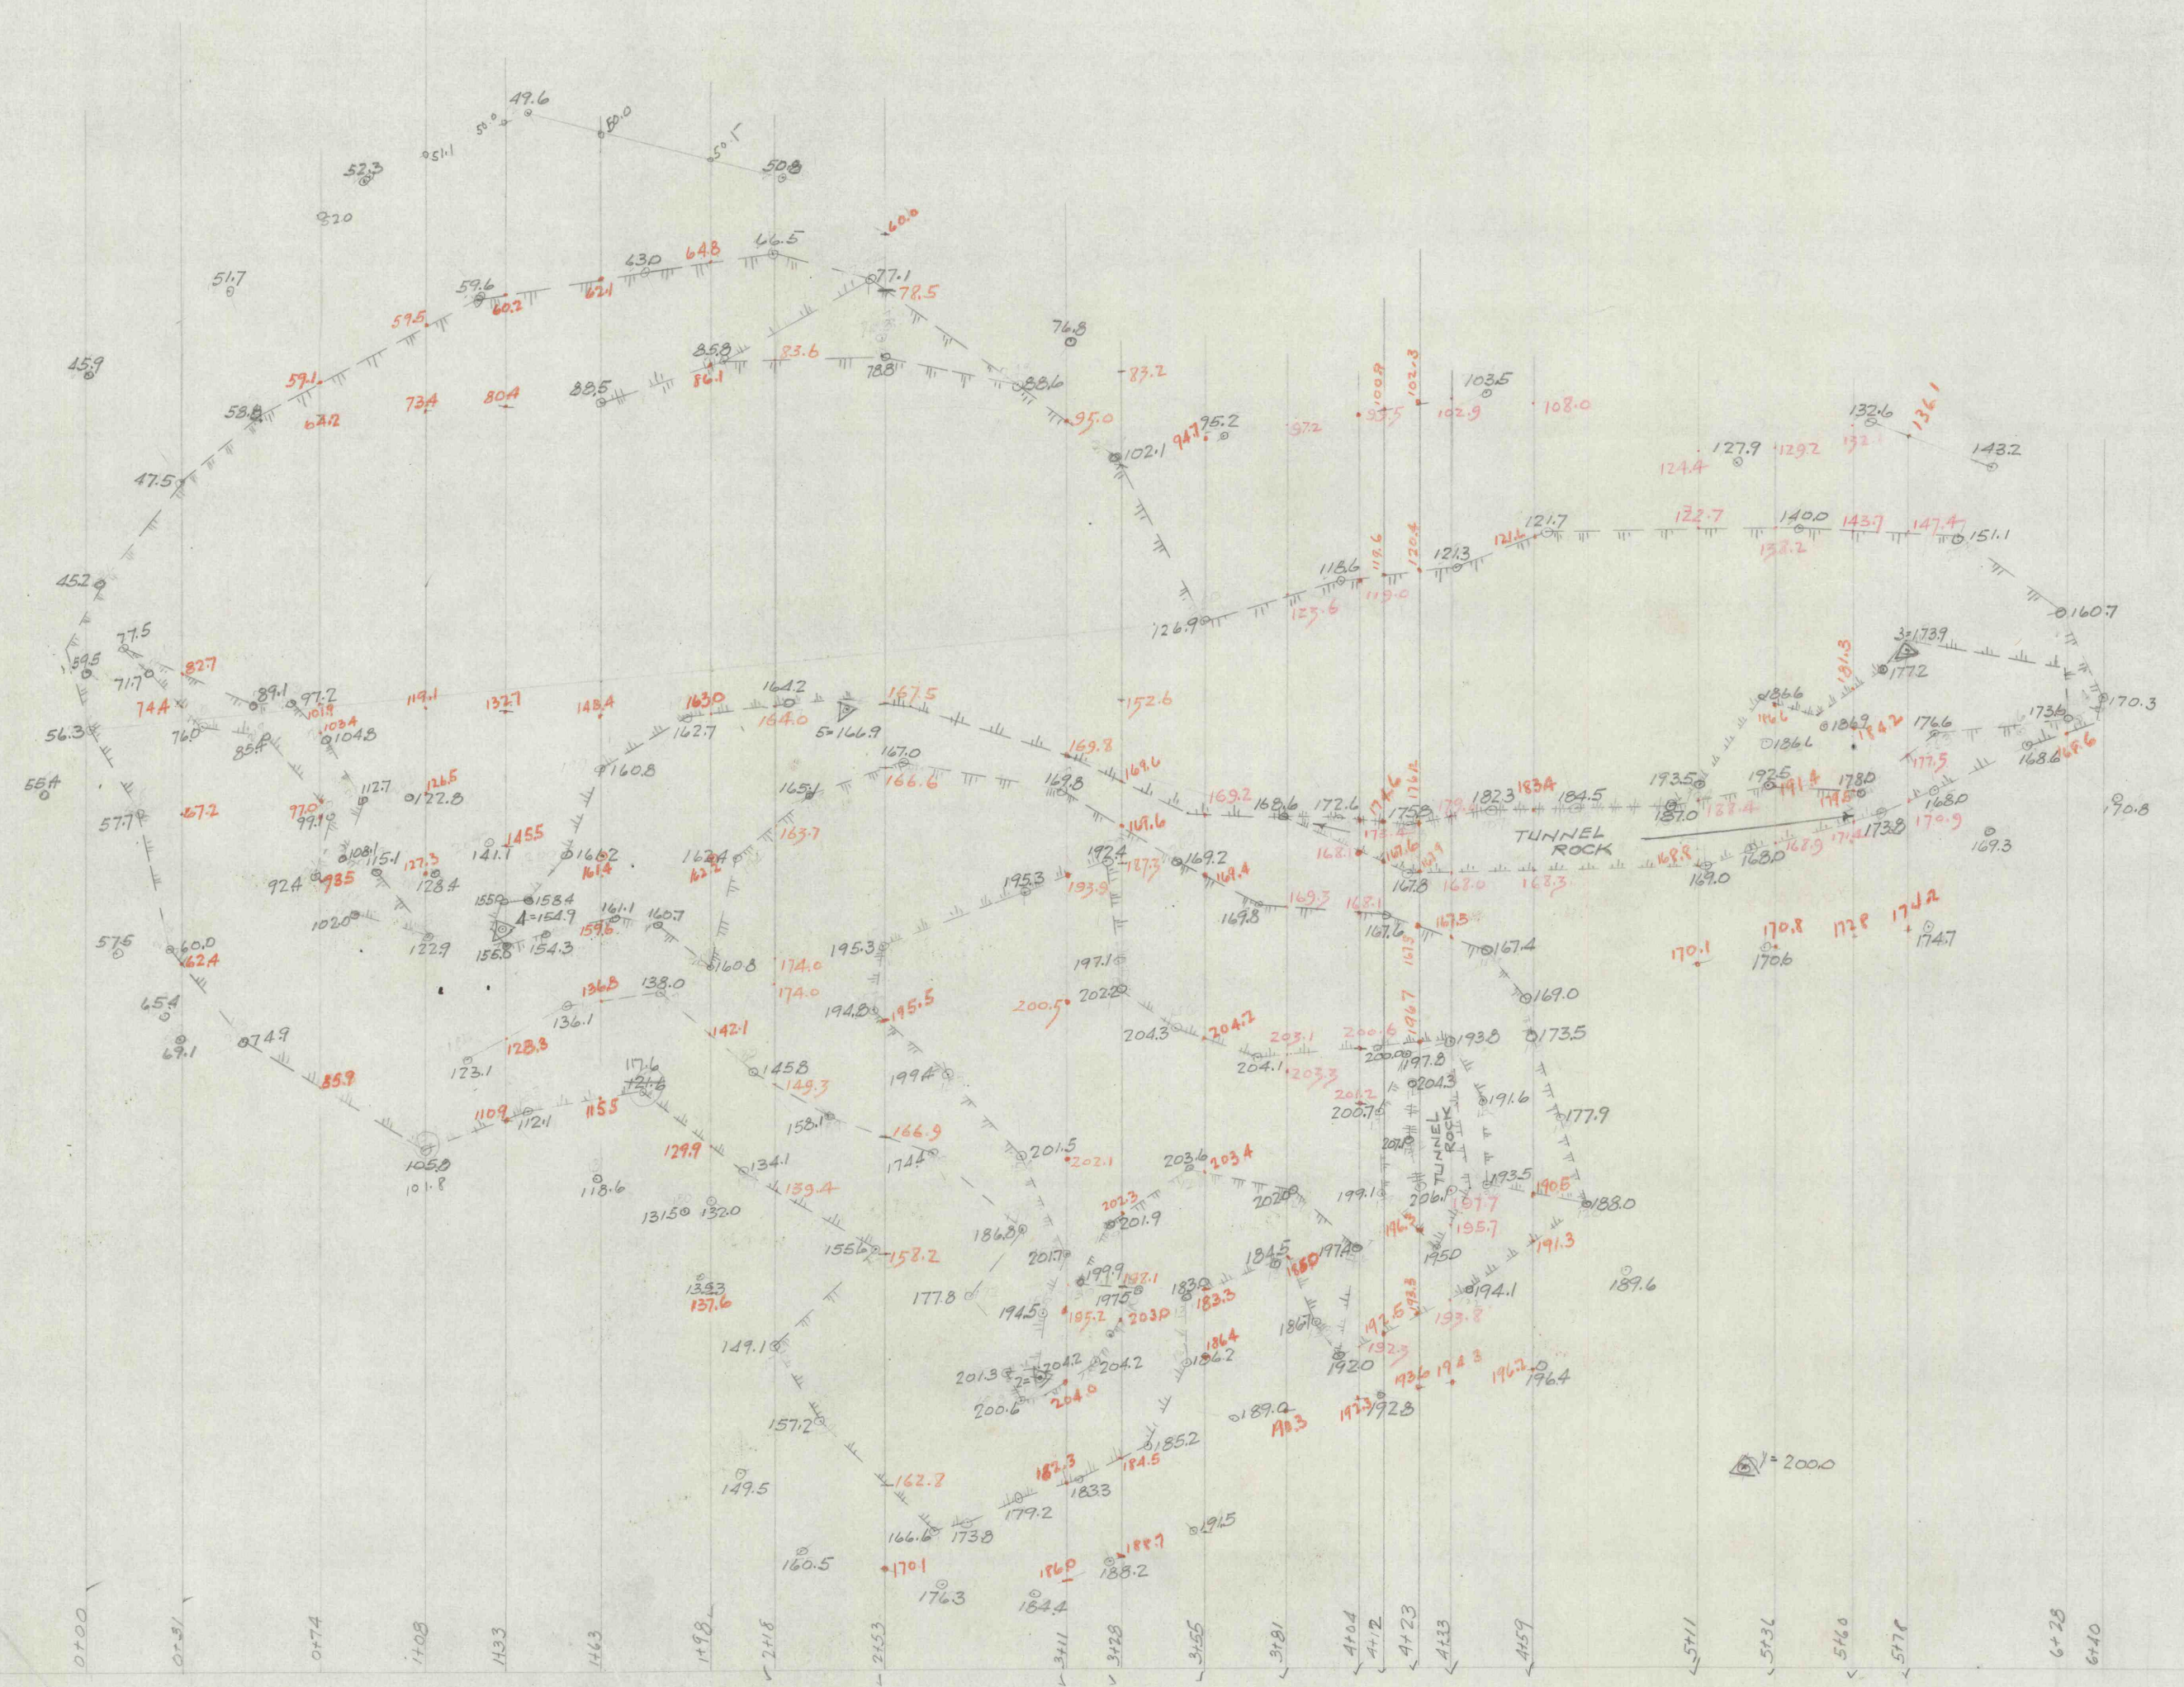

J. ROBERT BAZLEY, Inc.			
POTTSVILLE, PENNA.			
MAP SHOWING CULM			
BANK AT EAST MINES			
DATE	SCALE	BY	1 OF 2
1/15/43	1"=50'		DRWG. NO.

ES2

ES2