


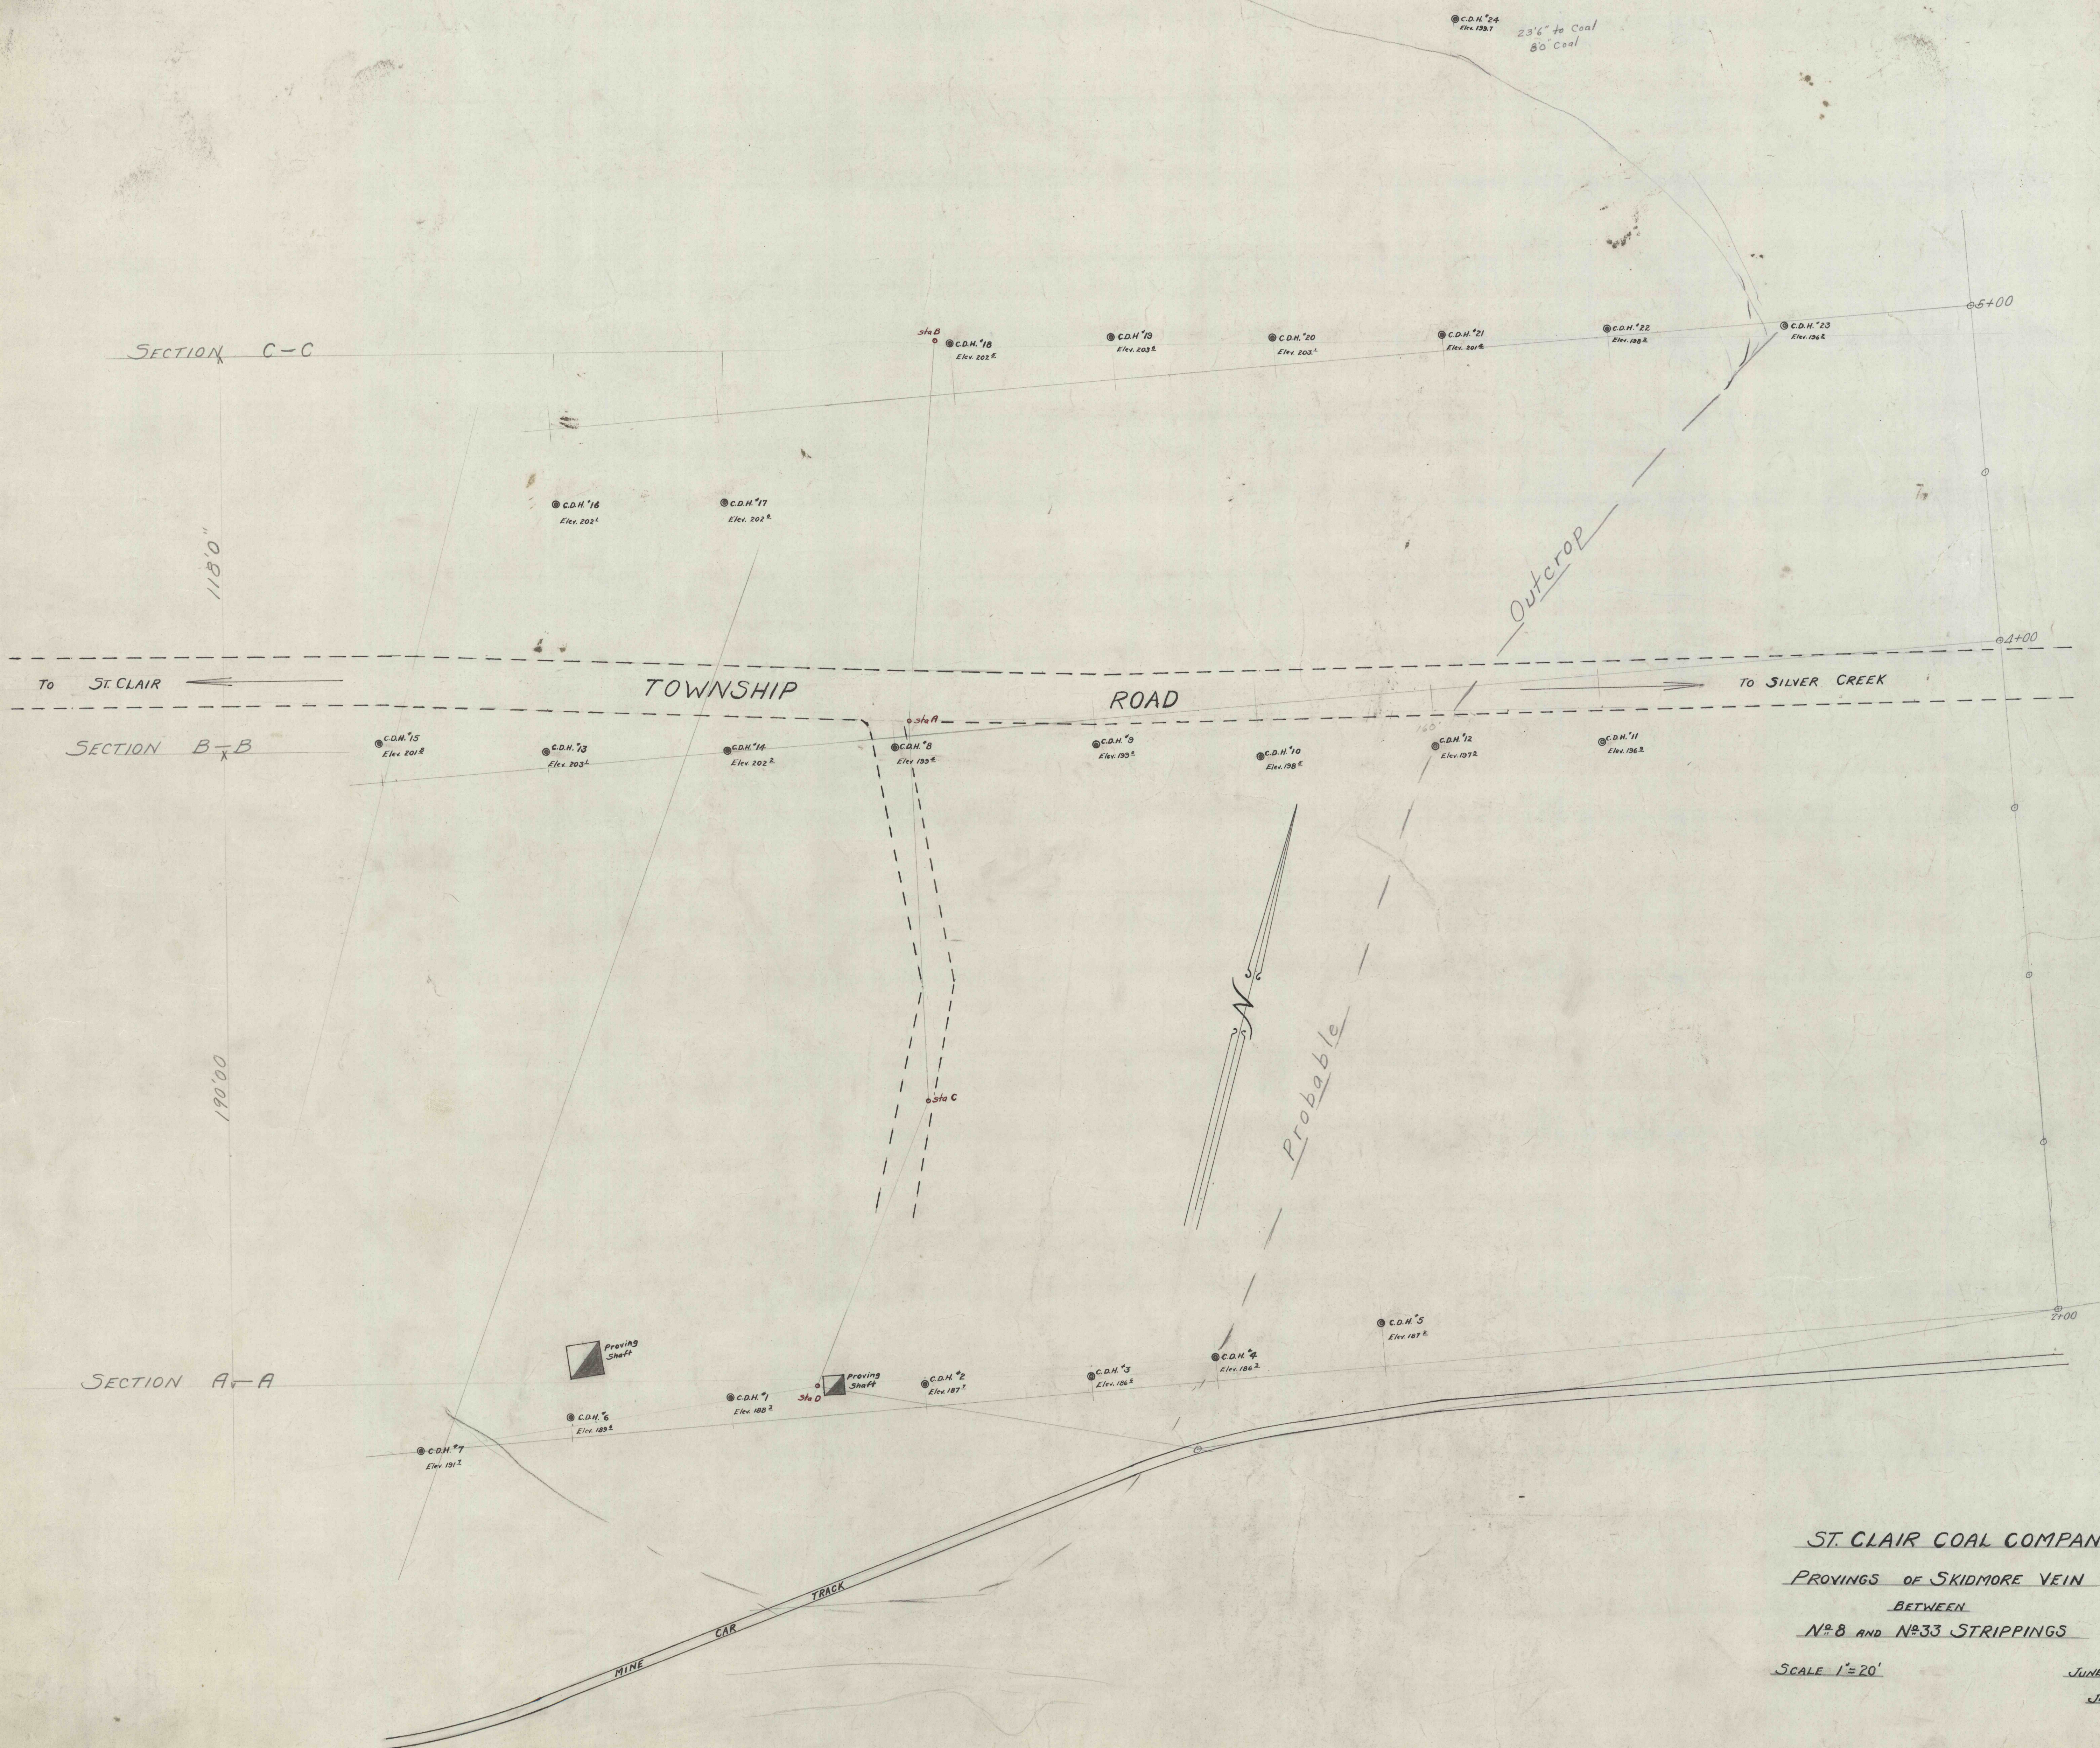

ST. CLAIR COAL COMPANY
 PROVINGS OF SKIDMORE VEIN
 BETWEEN
 N^o 8 AND N^o 33 STRIPPINGS

SCALE 1" = 20'

JUNE 7th 1935

J. ROBERT BAZLEY, INC.