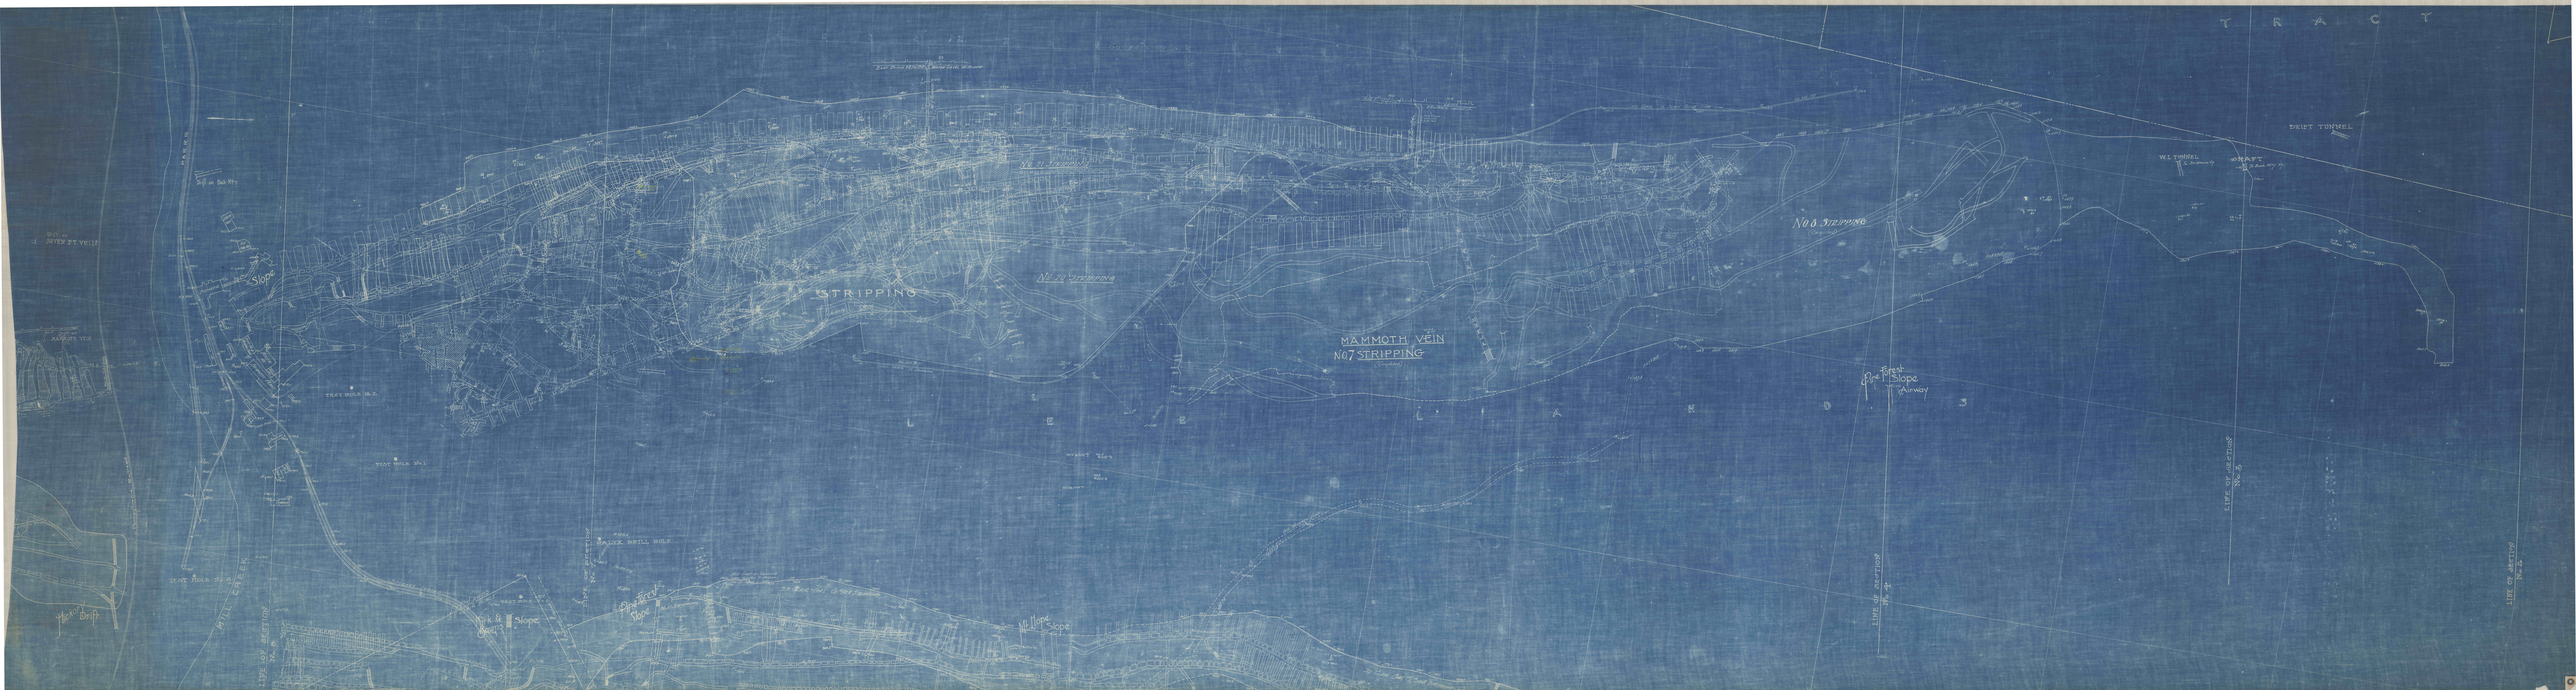

TRACT
Drift on SEVEN FT. VEIN
Drift on MAMMOTH VEIN
Drift on Buck Mt'n
Smith Shop
Breaker
Slope
Boiler Ho.
Briquette Plant
Garage
Pennsylvania Railroad
Hickory Drift
MILL CREEK
TEST HOLE No. 1
TEST HOLE No. 2
TEST HOLE No. 4
CALYX DRILL HOLE
Storage Tracks
ST. CLAIR TRACT
Kirk & Baums Slope
Pine Forest Slope
No. 51 Stripping
St. Clair Coal Co. 50 A Stripping
Mt. Hope Slope
LINE OF SECTION No. 8
LINE OF SECTION No. 7
LINE OF SECTION No. 4
LINE OF SECTION No. 3
LINE OF SECTION No. 2
East Buck Mt'n Vn. Water Level of Slope
STRIPPING
No. 21 STRIPPING
No. 20 STRIPPING
MAMMOTH VEIN
No. 7 STRIPPING
(Completed)
PLANE
No 8 STRIPPING
(Completed)
Pine Forest Slope
Airway
L E E L A N D S
Old Mahanoy Road
W.L. TUNNEL
To Skidmore Vn
SHAFT
To Buck Mt'n Vn.
DRIFT TUNNEL