


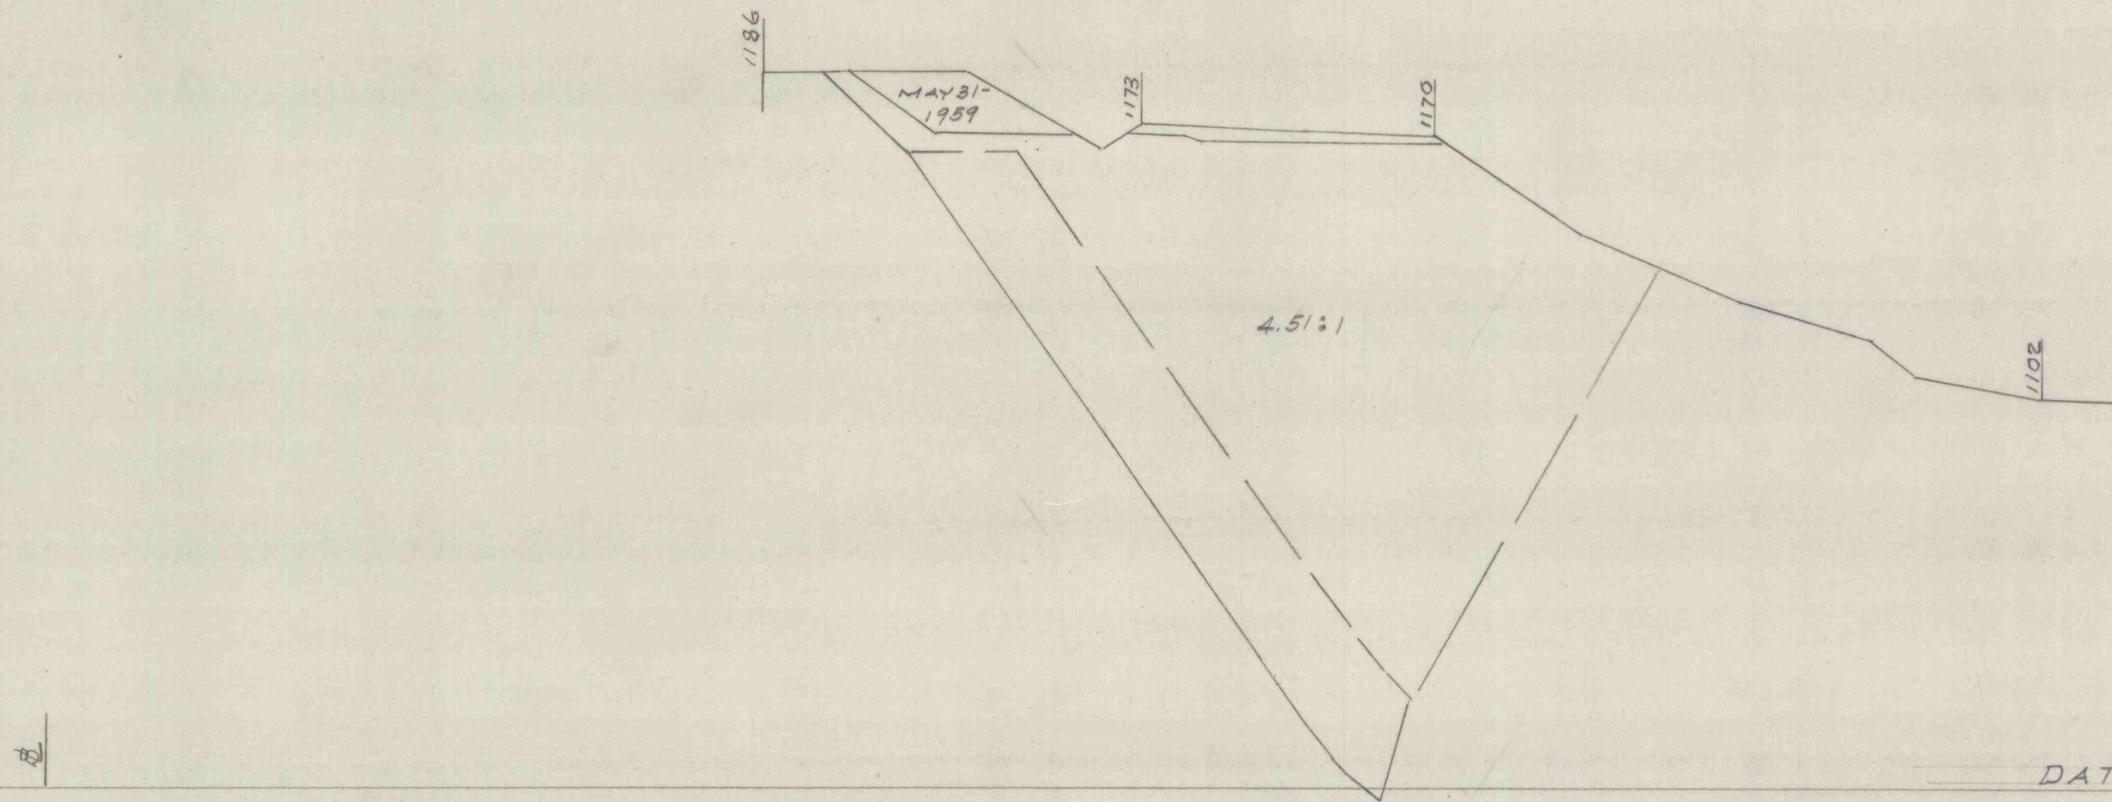

JAYRE MAMMOTH VEIN
STRIPPING - SOUTH SIDE
SECTION 10+00 WEST
SCALE 1"=50' 6-3-59