


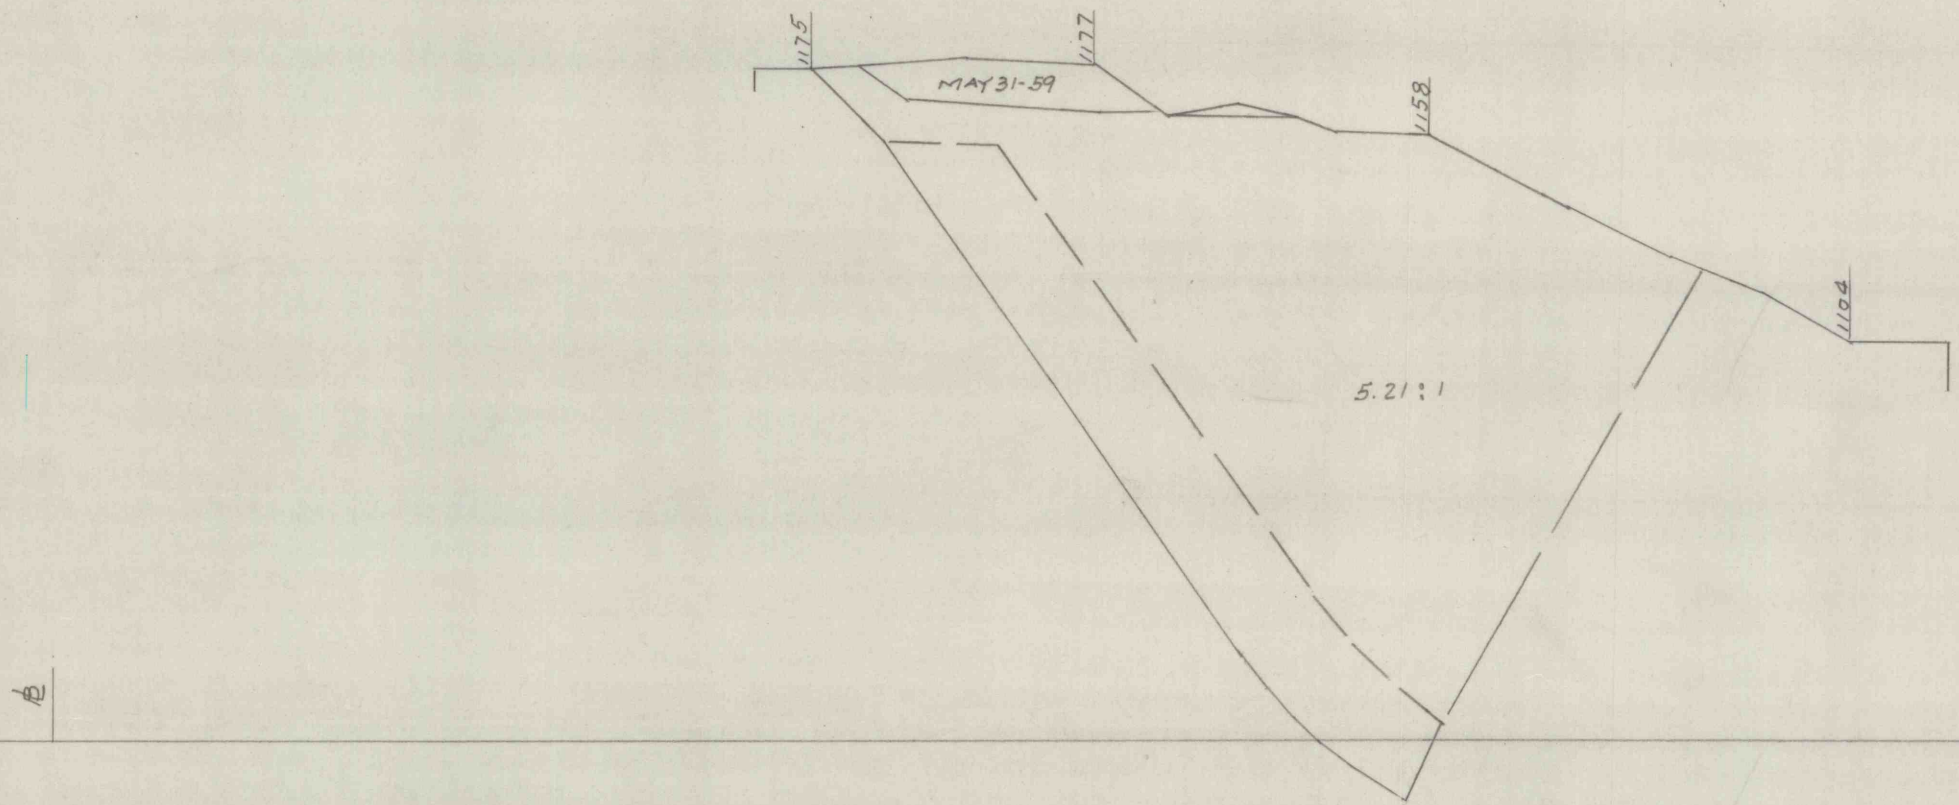

SAYRE MAMMOTH VEIN
STRIPPING-SOUTH SIDE
SECTION 11+00 WEST
SCALE 1"=50' 6-3-59