



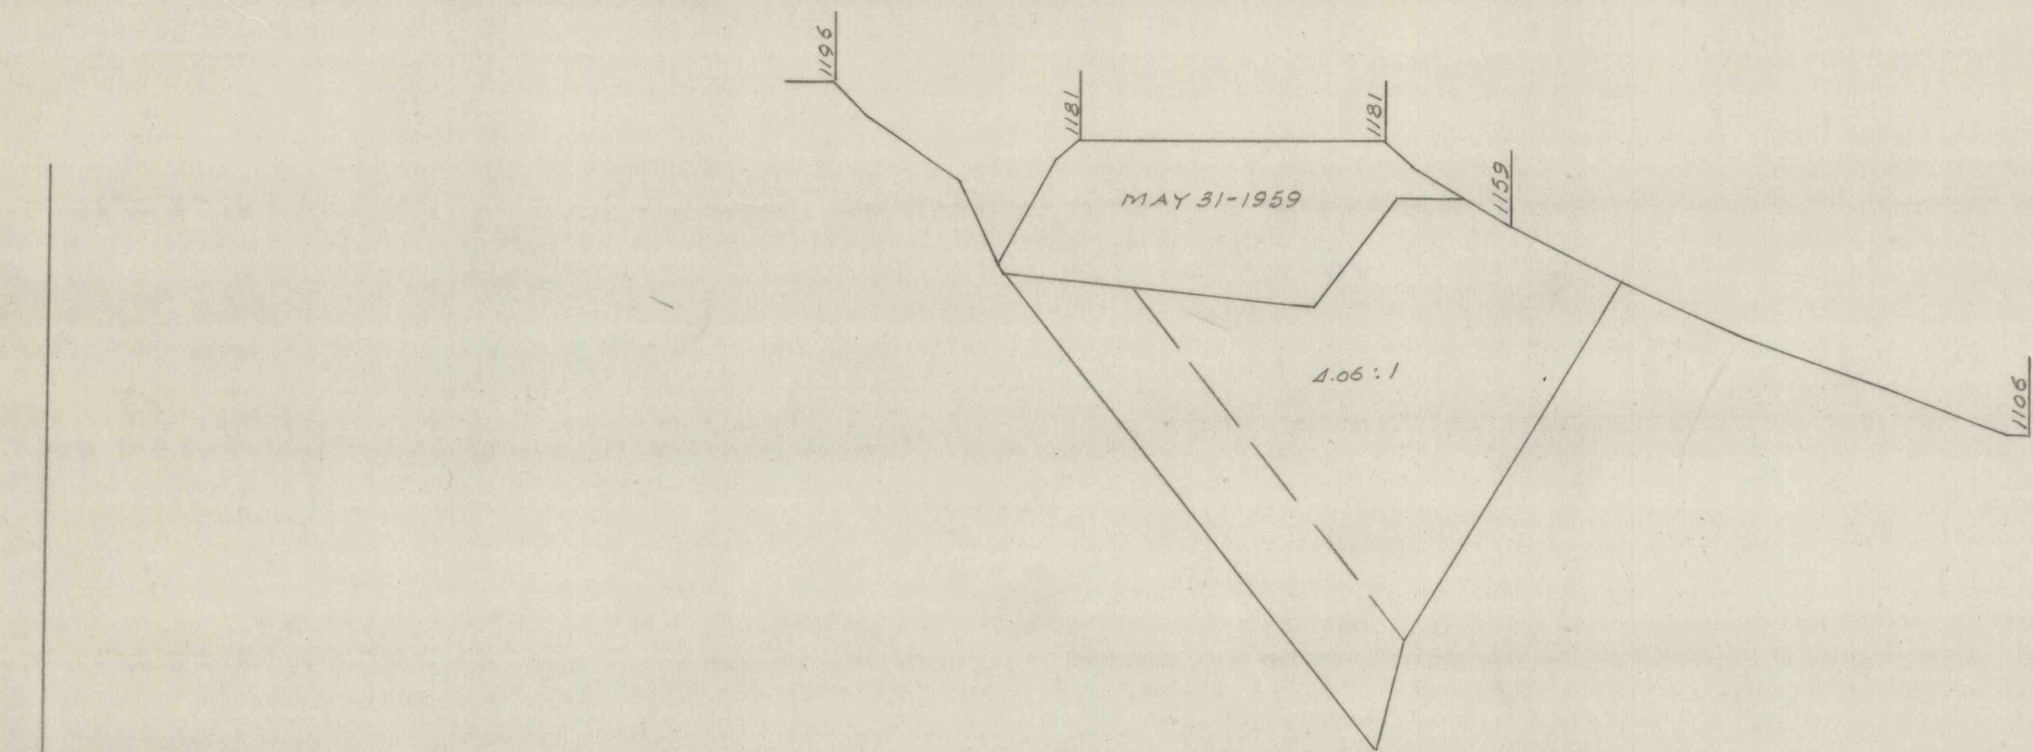

DATUM 1000.0

N

 

SAYRE MAMMOTH VEIN
STRIPPING - SOUTH SIDE
SECTION 9+00 WEST
SCALE 1"=50' 6-3-59