


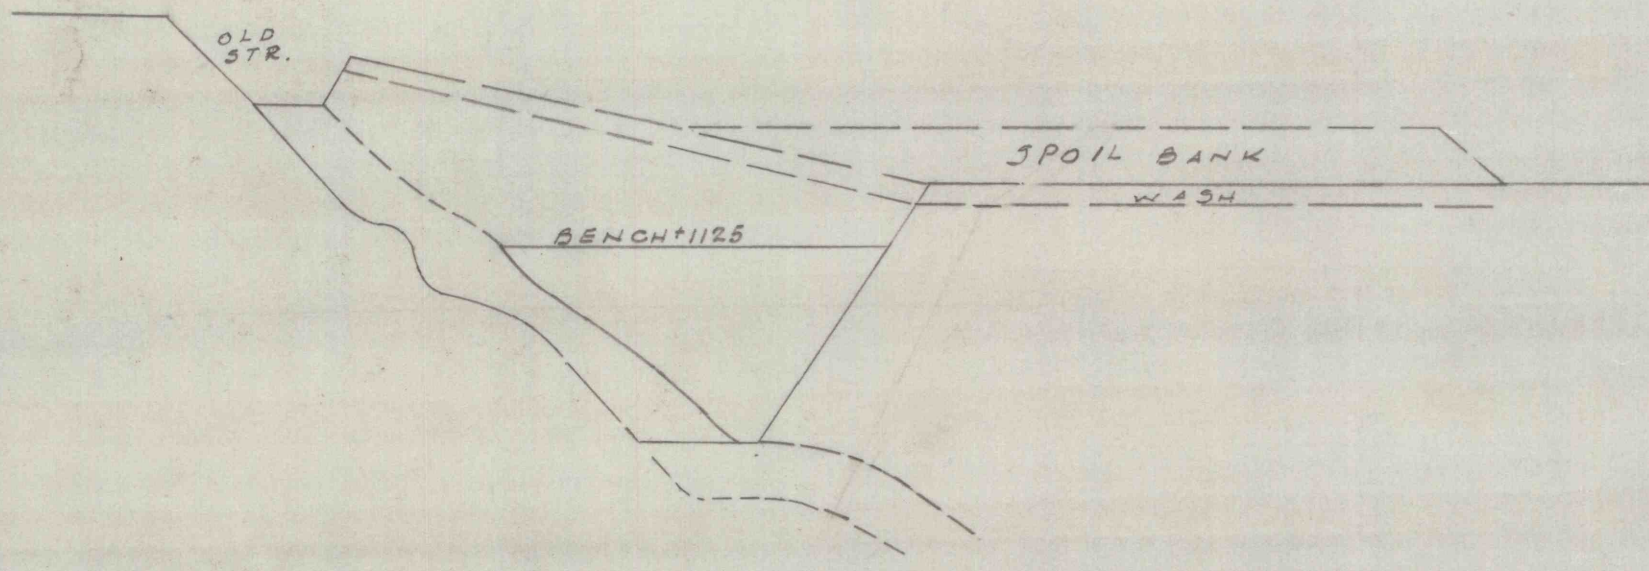

DATUM 900.0

N

SUSQUEHANNA COLLIERIES CO
SAYRE MAMMOTH VEIN STRIPPING
SECTION 3000 EAST OF SAYRE SHAFT
AT WEST FACE OF STRIPPING
SCALE 1"=100' 7-9-58