


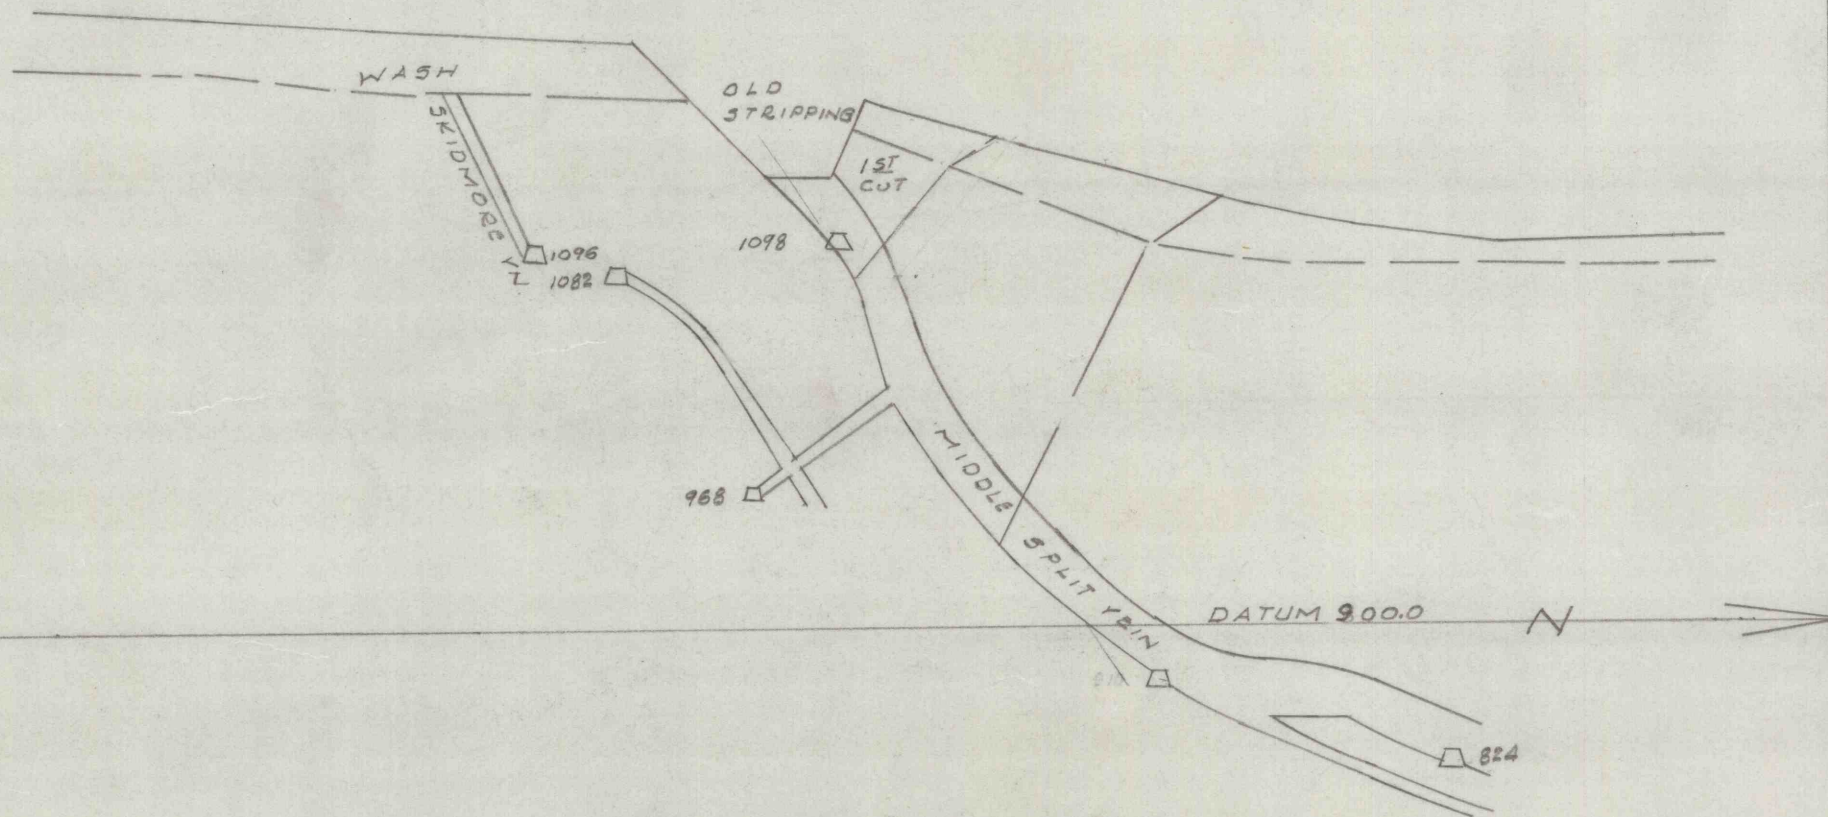

SUSQUEHANNA COLLIERIES CO
JAYRE MAMMOTH VEIN STRIPPING
SECTION #11-670 WEST OF STRIPPING FACE
SCALE 1"=100' 7-9-58