


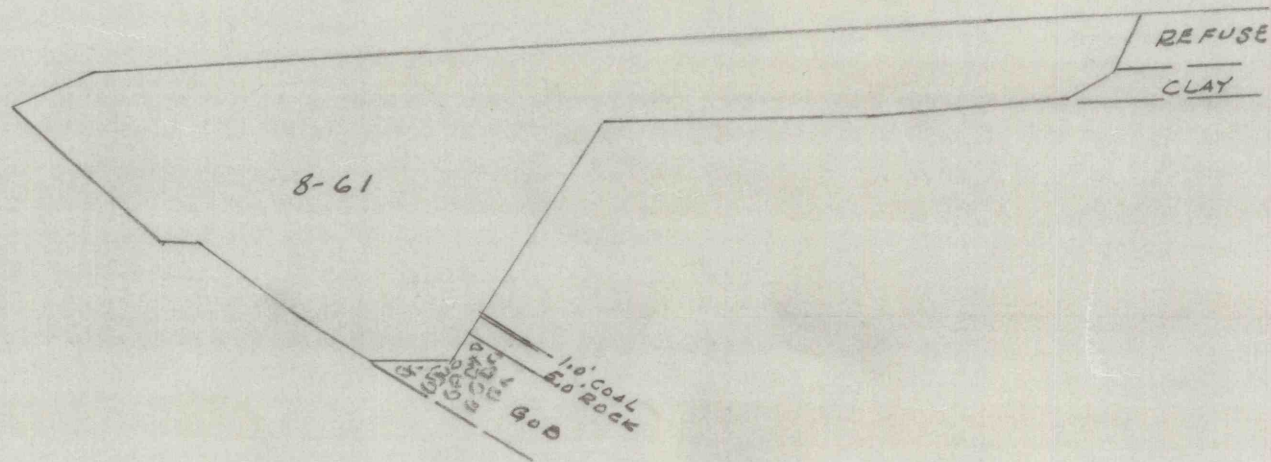

988.0 APPROX WATER LEVEL

DATUM 1000.0

N

948.0

GAP ANTHRACITE CO.
JAYRE STRIPPING SOUTH SIDE
SECTION 32+50 W
SCALE 1"=50' SEPT. 20-1961