


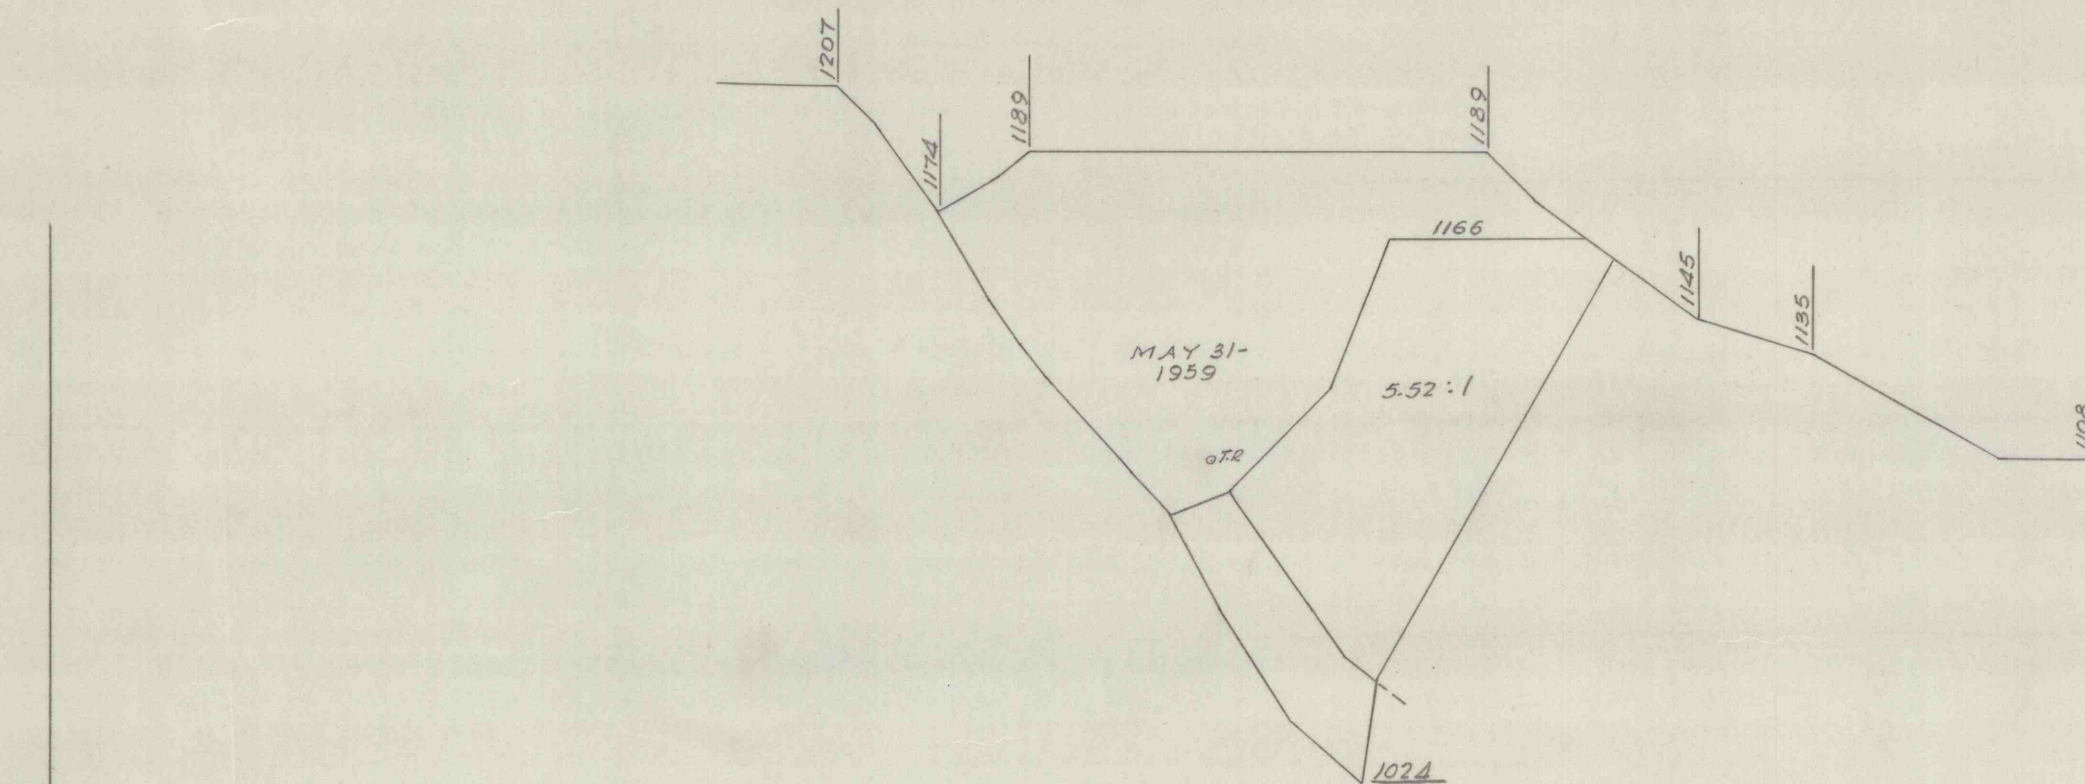

DATUM 1000.0

N

SAYRE MAMMOTH VEIN
STRIPPING - SOUTH SIDE
SECTION 8+00 WEST
SCALE 1"=50' 6-3-59