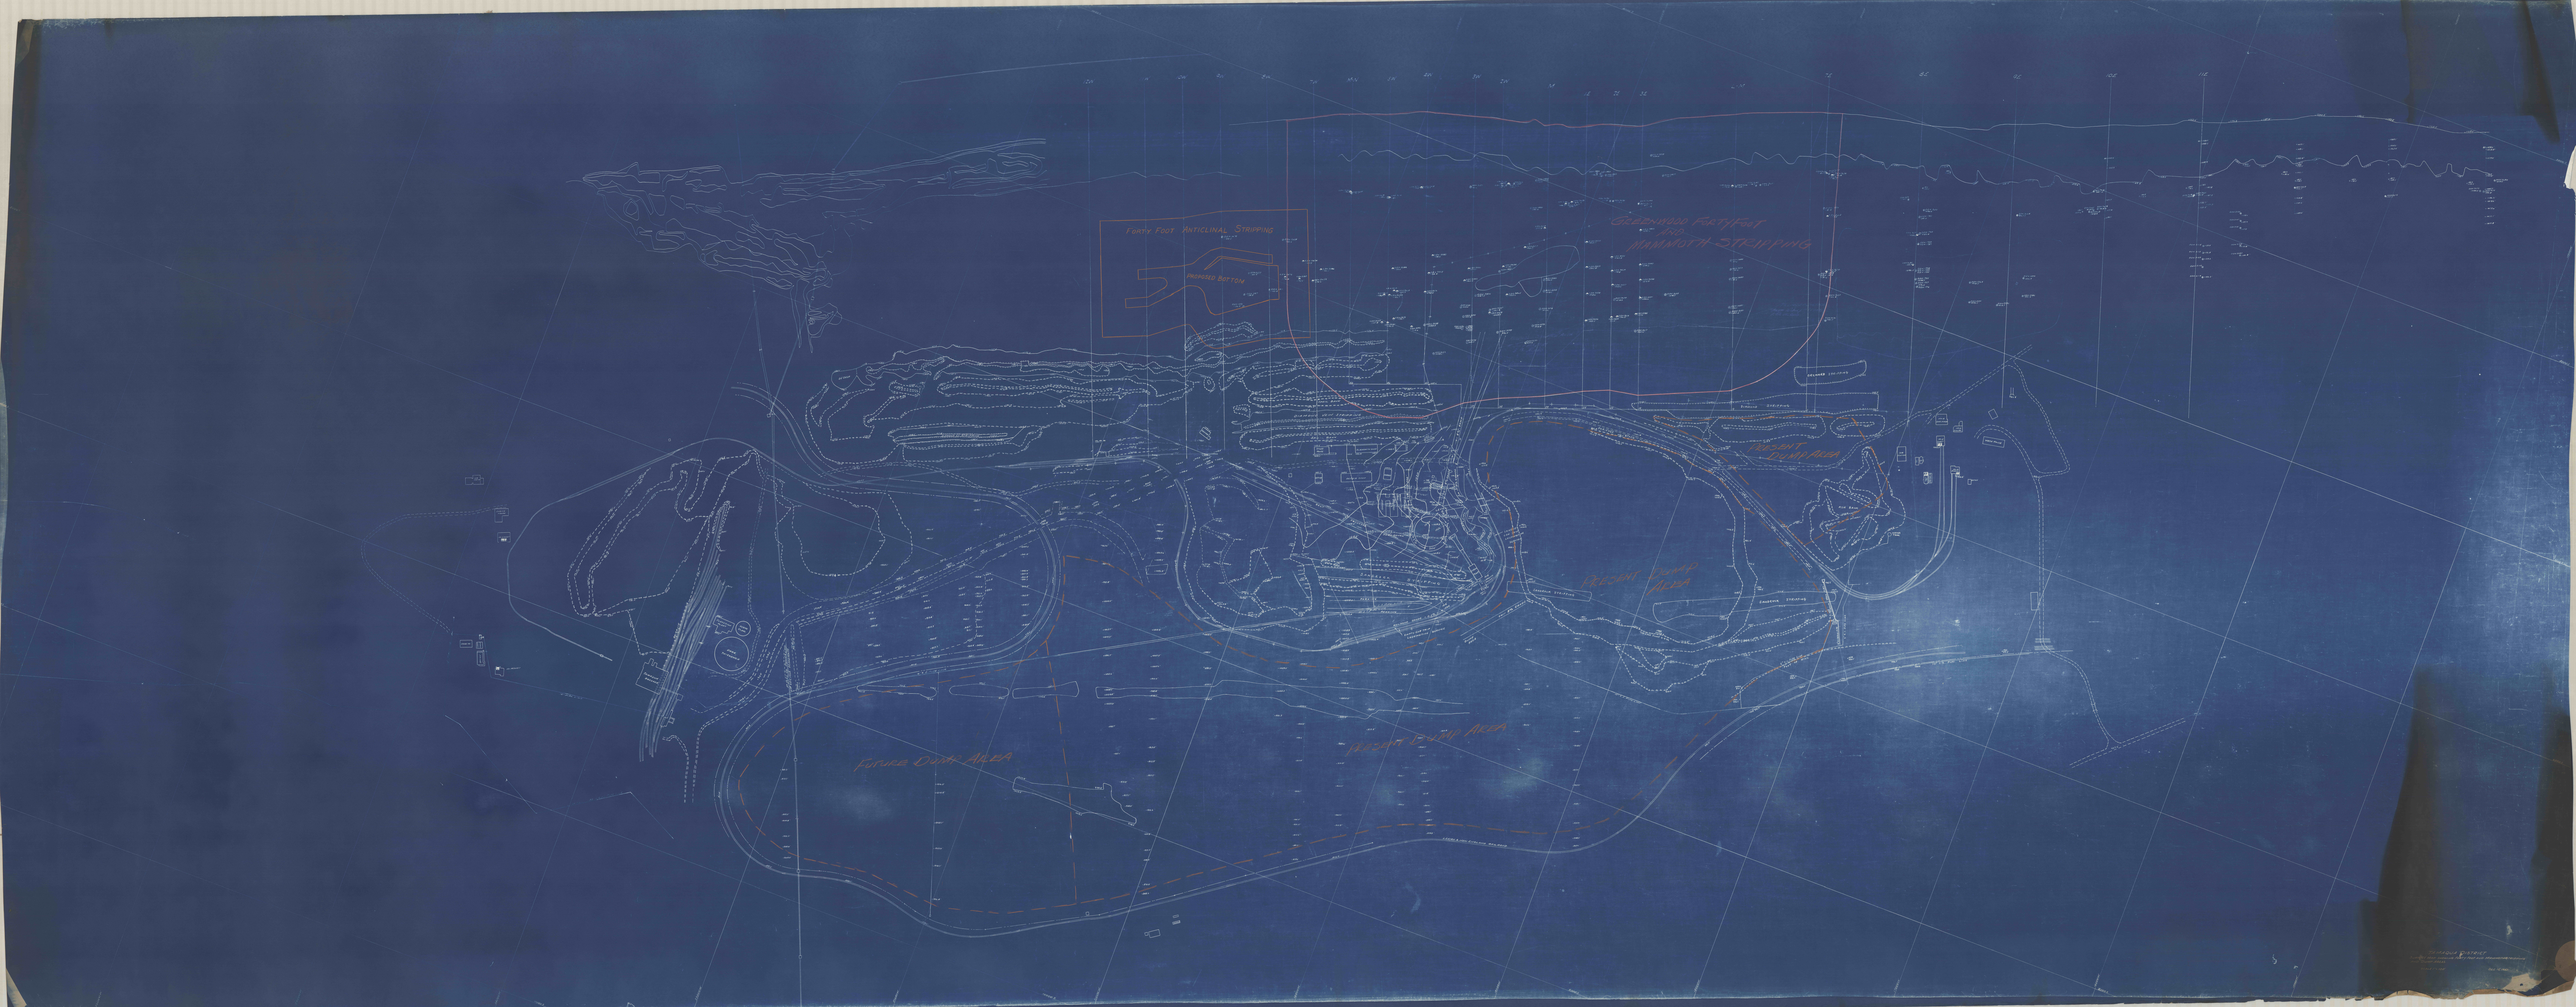
FORTY FOOT ANTICLINAL STRIPPING
PROPOSED BOTTOM
GUERNSEY FORTY FOOT AND MAMMOTH STRIPPING
PRESENT DUMP AREA
PRESENT DUMP AREA
PRESENT DUMP AREA
FUTURE DUMP AREA