


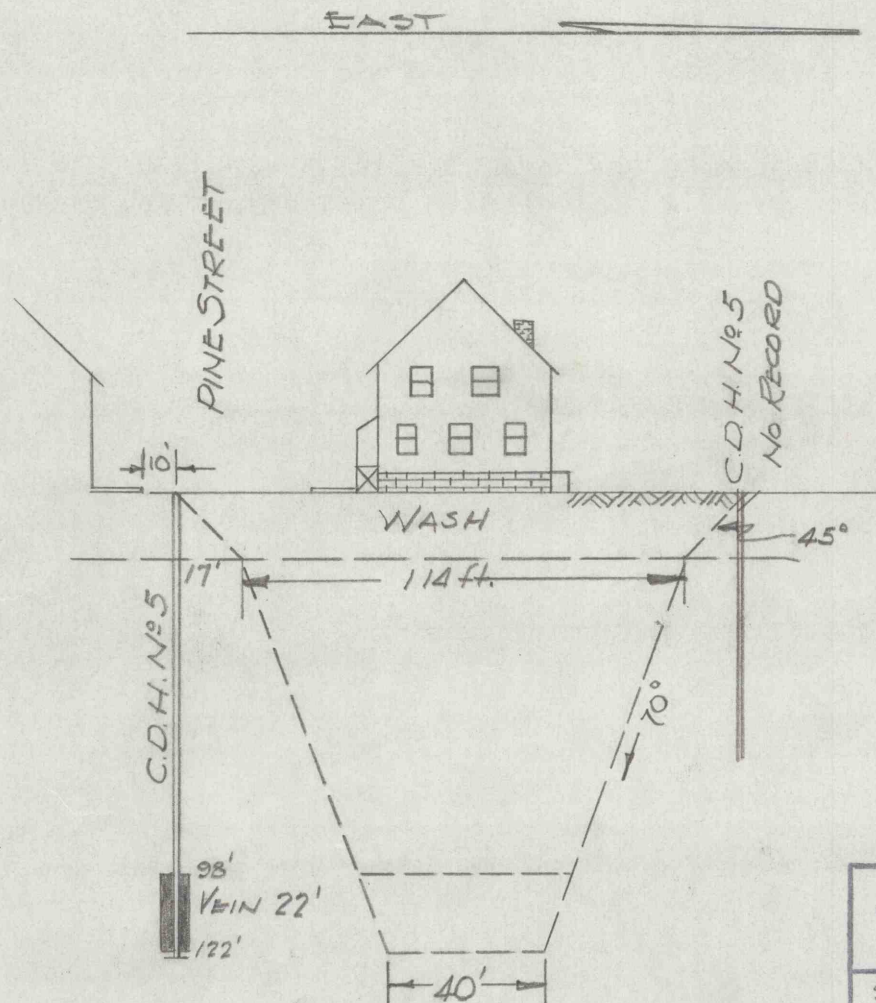

**J. ROBERT BAZLEY, Inc.**  
POTTSVILLE, PENNA.

SECTION THROUGH  
C.D. HOLE #5, MT. CARMEL  
FIRE AREA

|                 |                 |                    |
|-----------------|-----------------|--------------------|
| DATE<br>1-17-49 | SCALE<br>1"=50' | BY<br>J. R. BAZLEY |
|-----------------|-----------------|--------------------|