


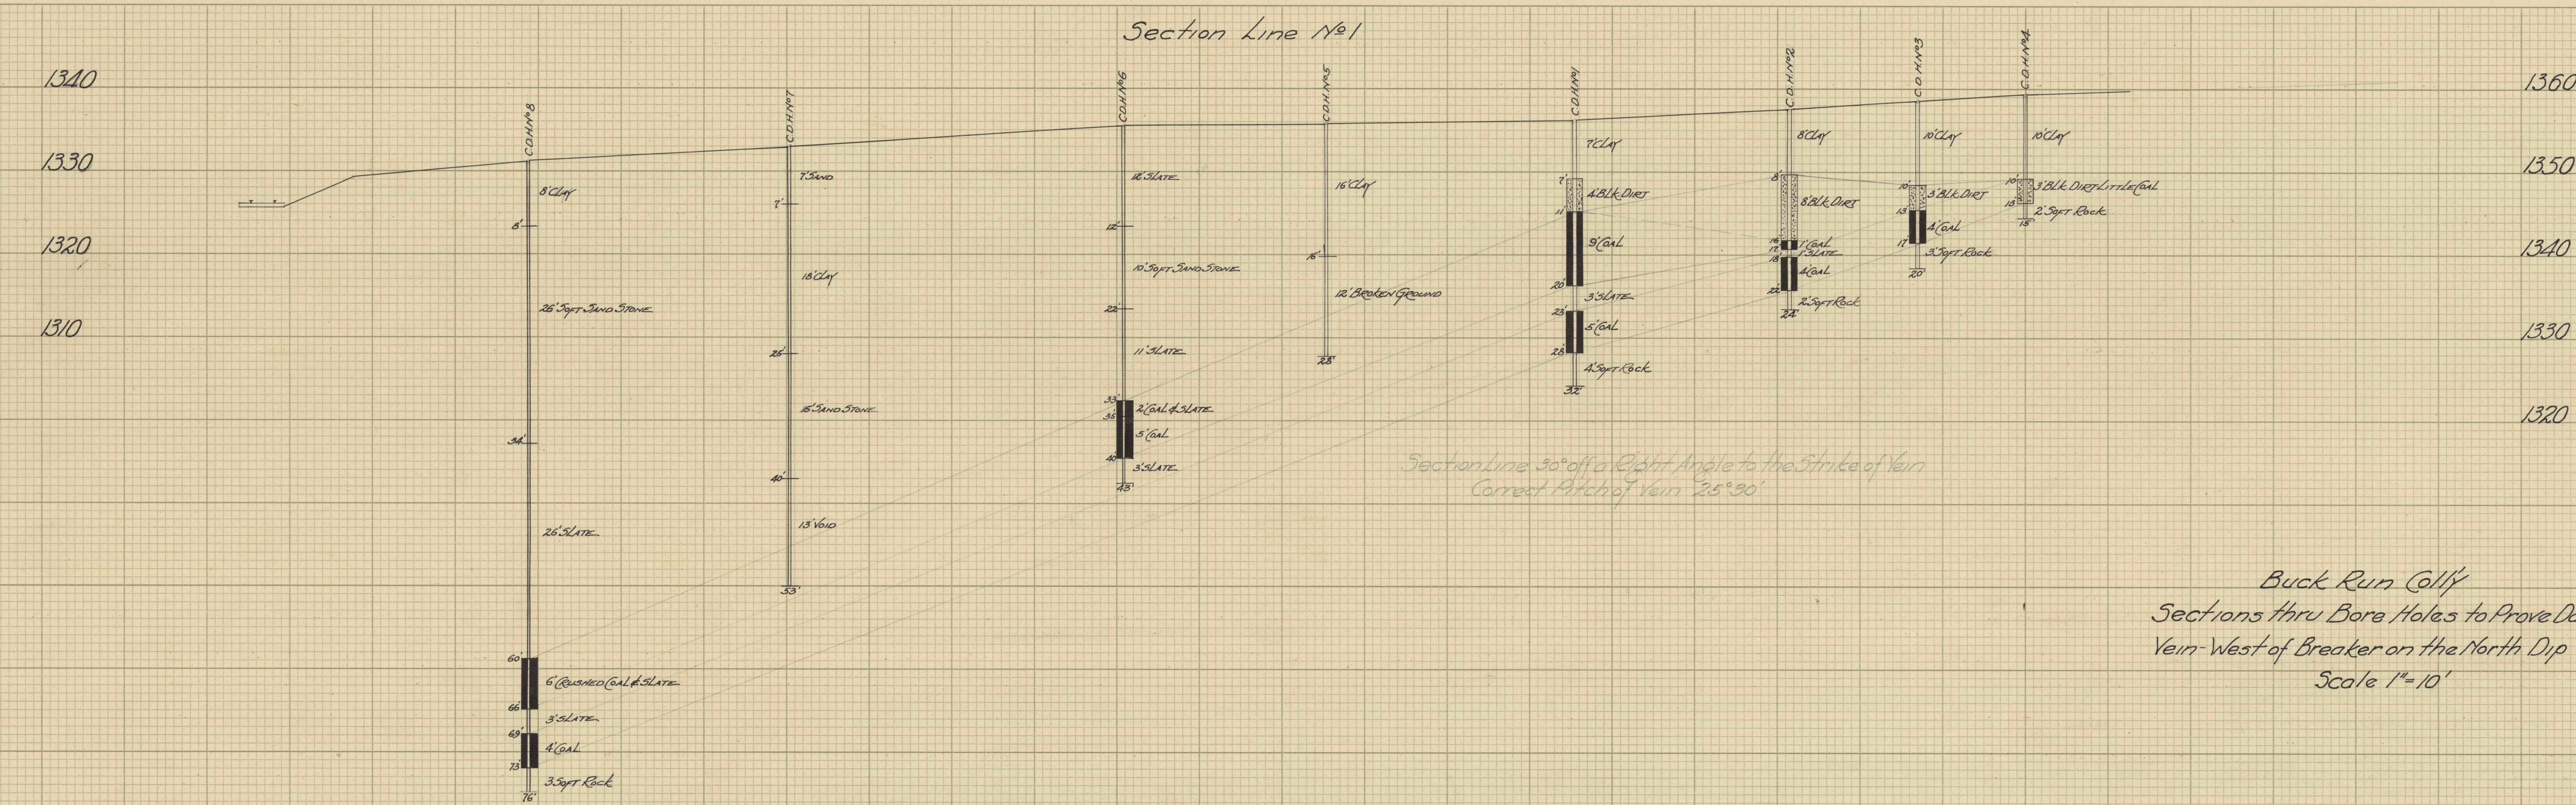

Buck Run Coll'y
Sections thru Bore Holes to Prove Daniel
Vein - West of Breaker on the North Dip
Scale 1" = 10'

