


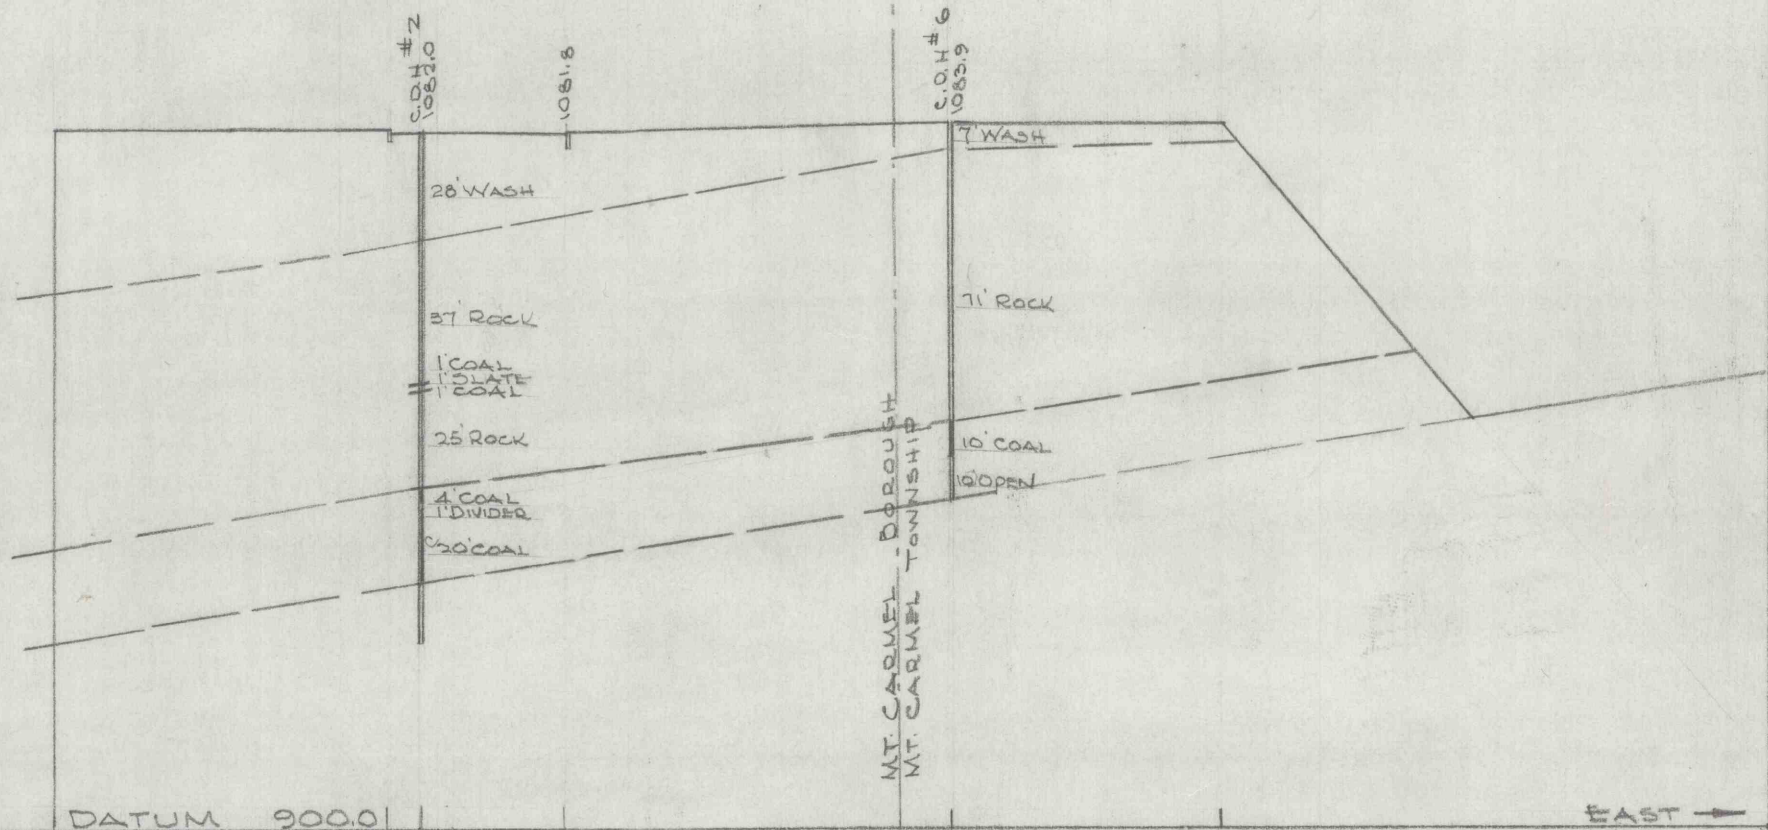

J. ROBERT BAZLEY, Inc.
POTTSVILLE, PENNA.

SECTION #1

THROUGH DRILL HOLE #2

MT. CARMEL FIRE AREA

DATE	SCALE	BY	
1-17-49	1"=50'		J. ROBERT BAZLEY, Inc.