KEUFFEL & ESSER CO.
MADE IN U.S.A.

CROSS SECTION

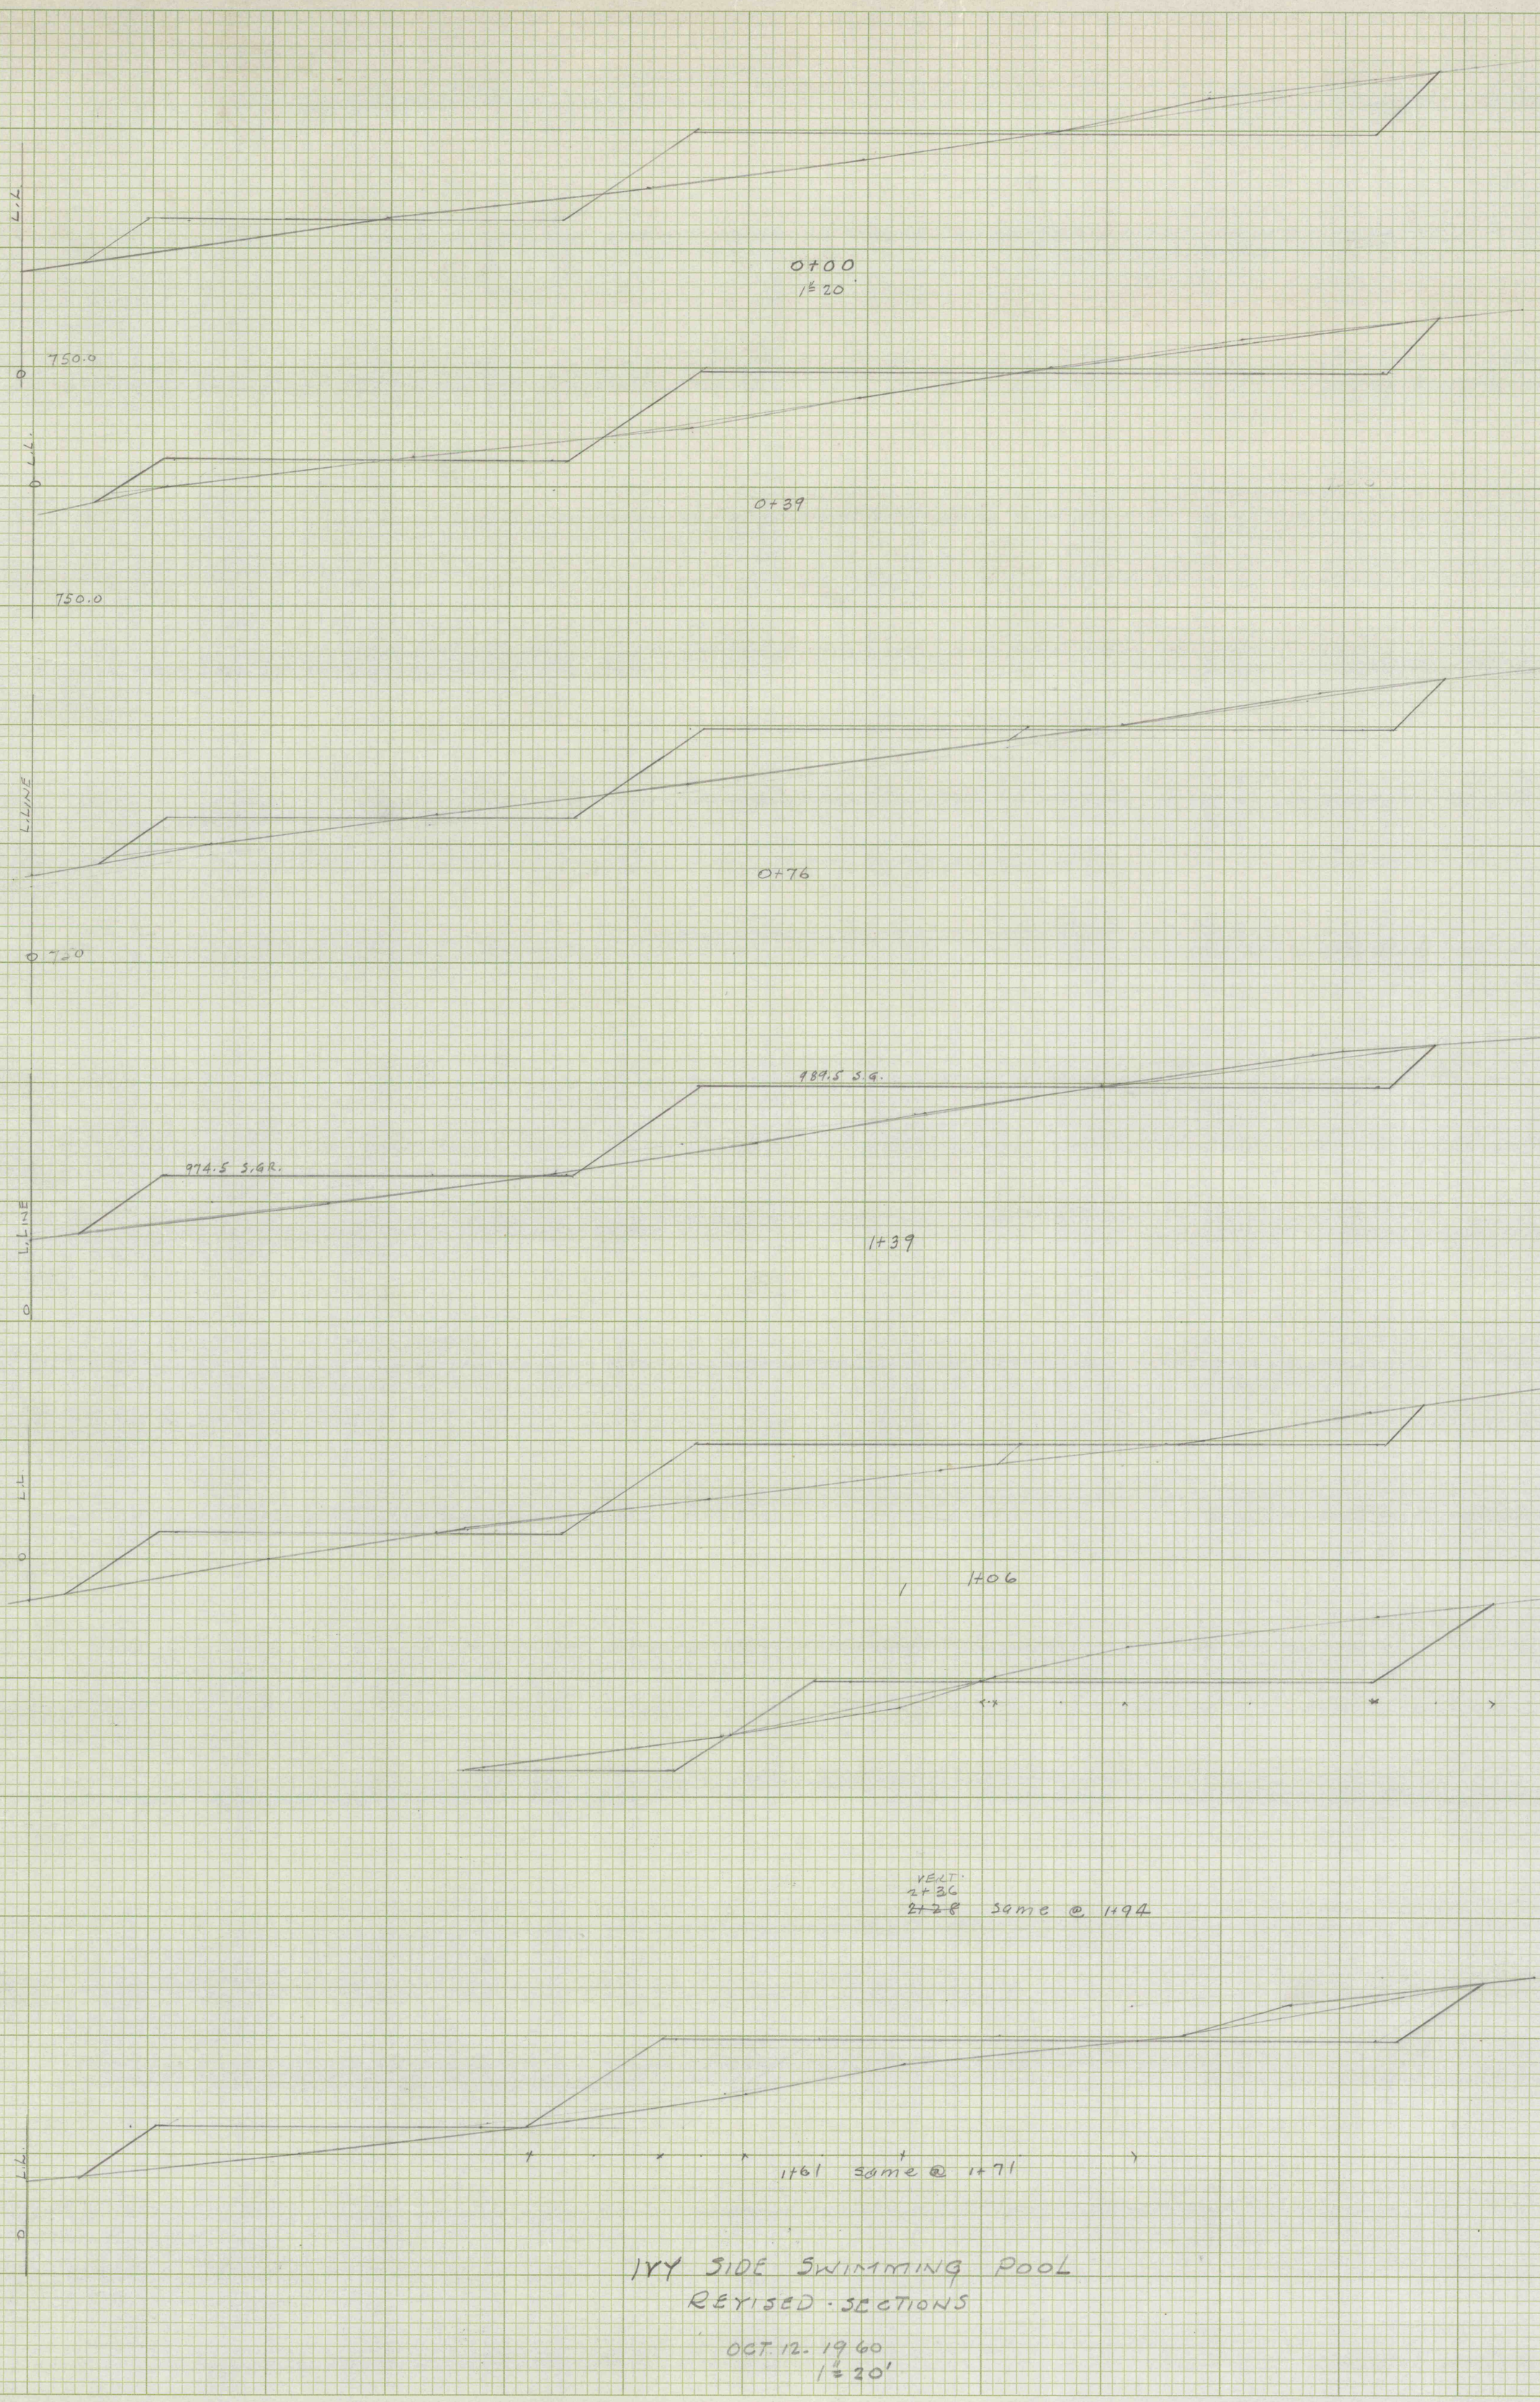

IVY SIDE SWIMMING POOL

REVISED SECTIONS

OCT. 12. 1960

1" = 20'