




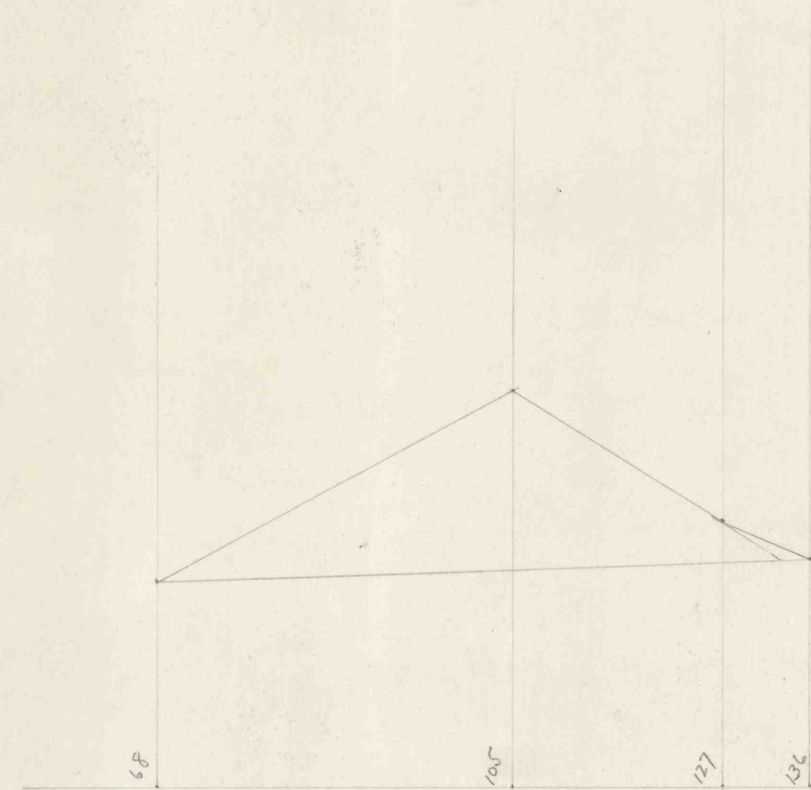


1+01

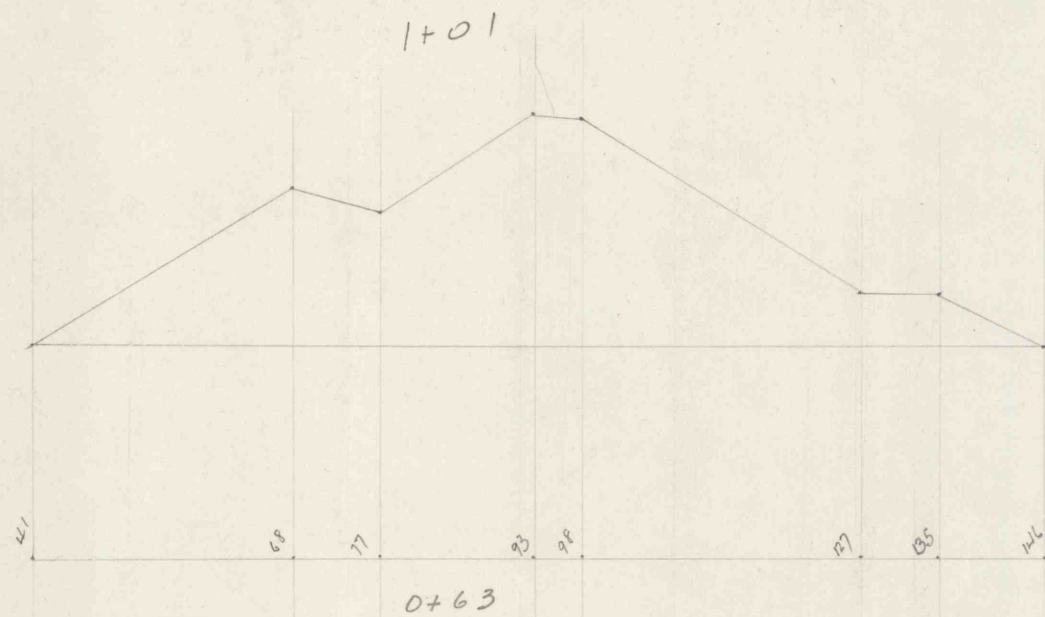


0+63

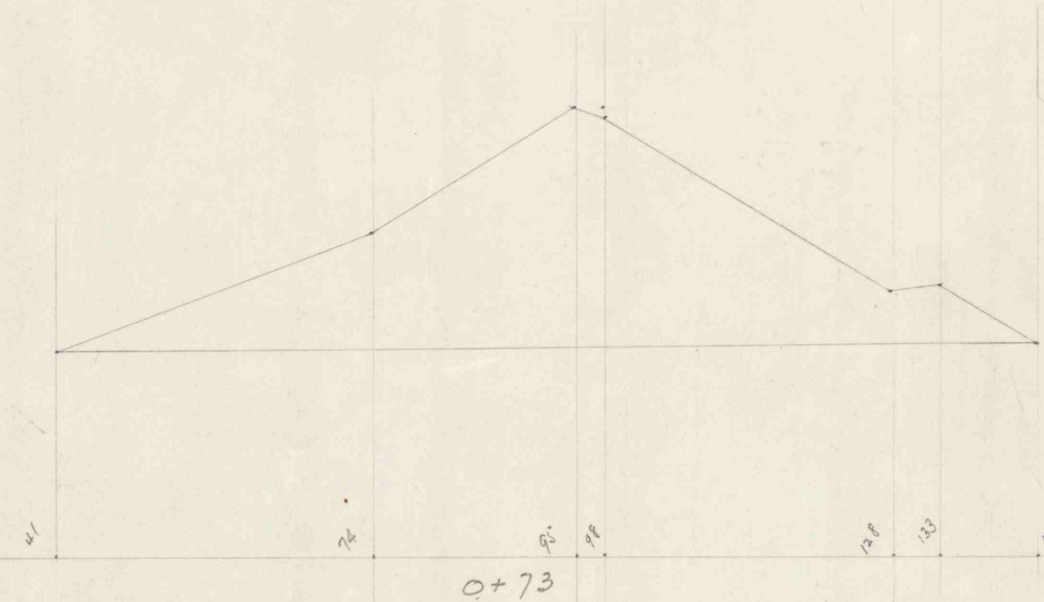

0+73

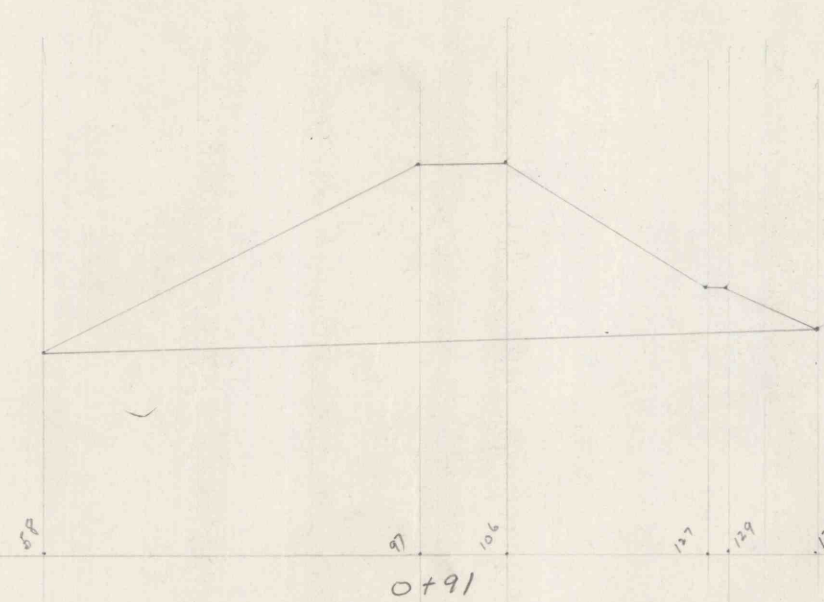


0+91

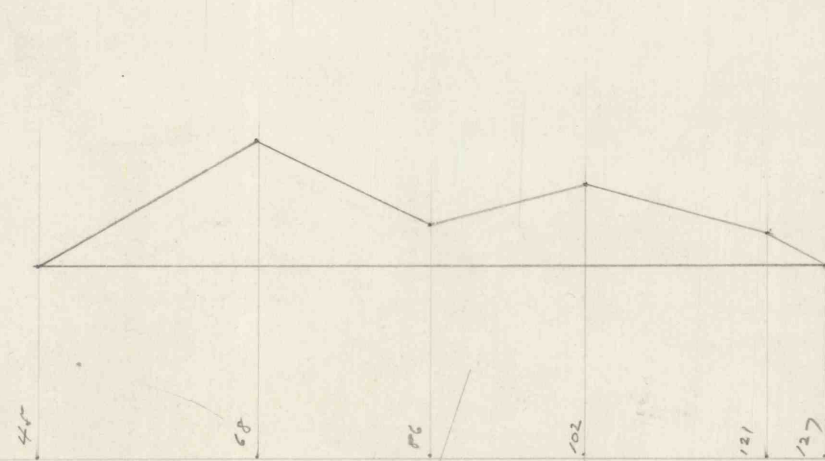


0+16

1" = 20'

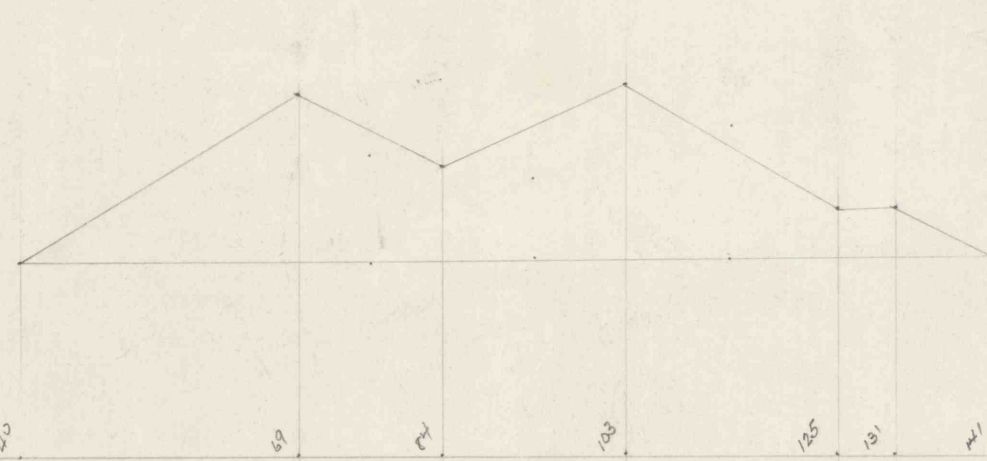

0+31

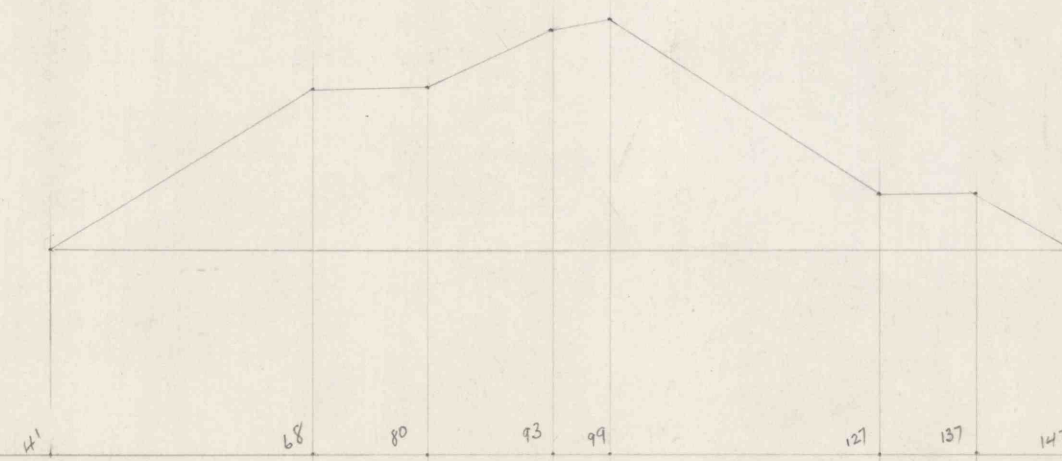

0+55

ST. CLAIR NO 22 STRIPPING
EGG & HUT COAL STOCK
BANK ON J. ROBERT BAZLEY INC. LEASE
1" = 20' MAY 10-1955