


Datum

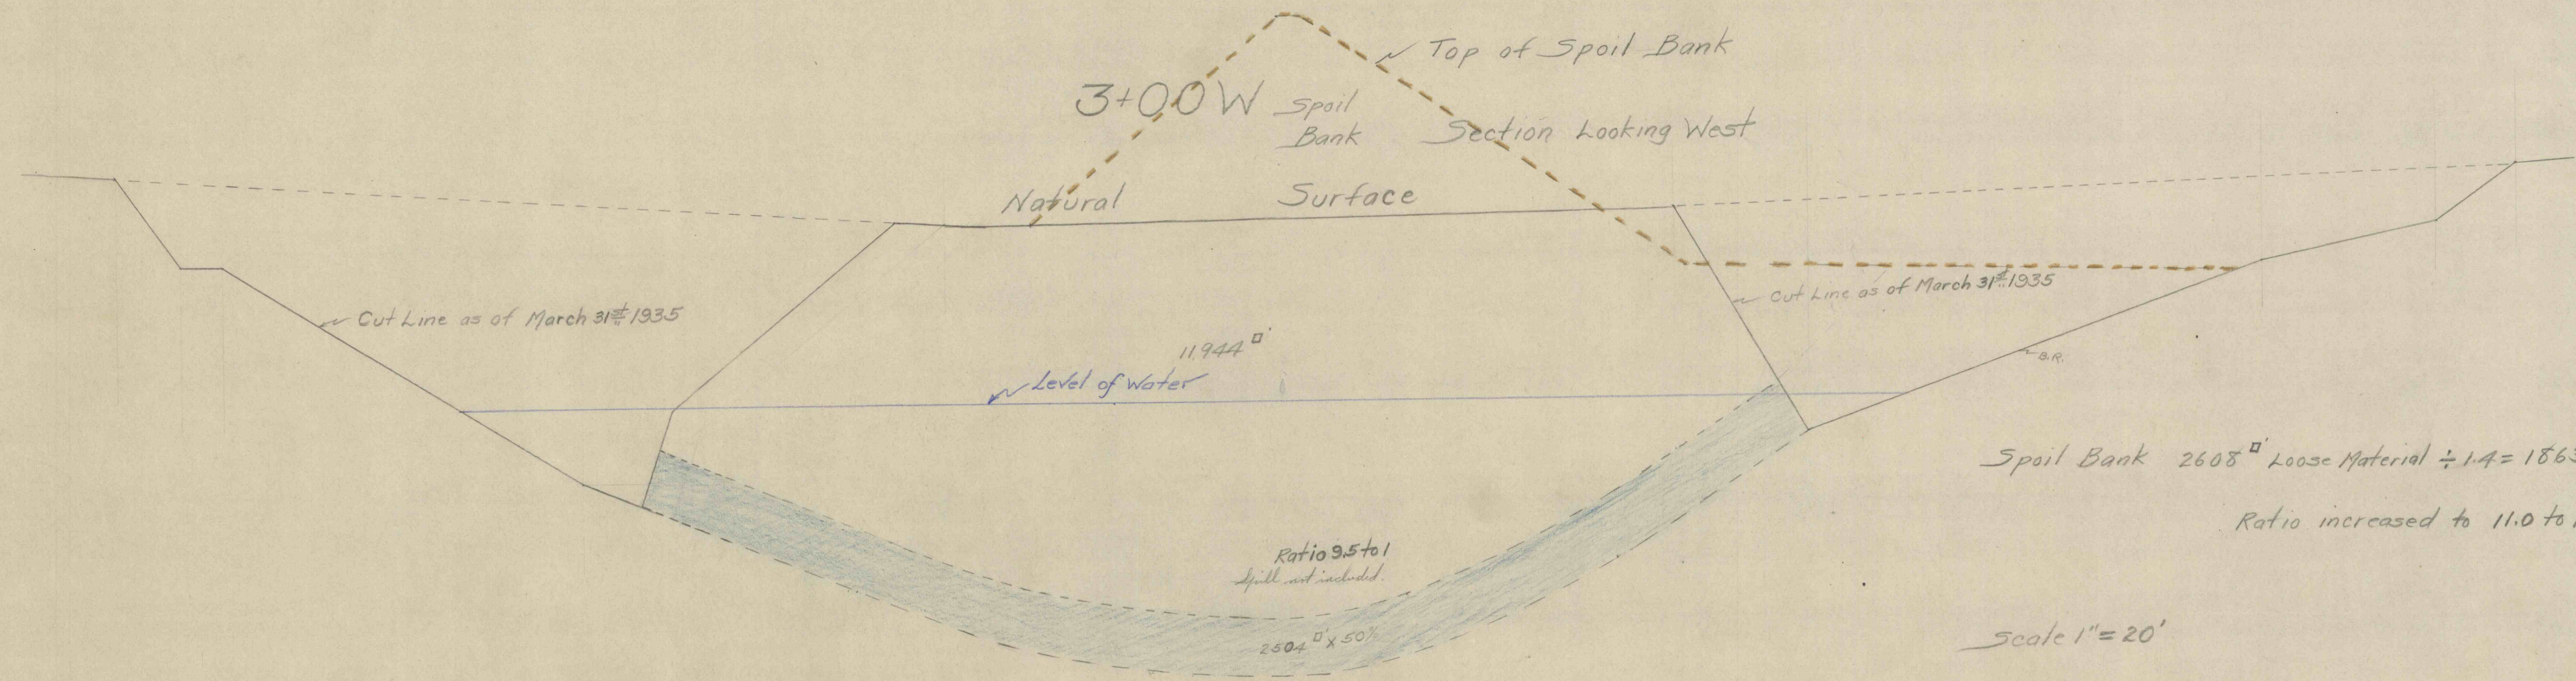

Spoil Bank $2608' \text{ Loose Material} \div 1.4 = 1863' \text{ Solid}$
Ratio increased to 11.0 to 1

Scale 1" = 20'

2+00 N

3+00 N

4+00 N

5+00 N

6+00

850.00