


# SILVER CREEK - #42 BUCK MTN. STRIPPING

## Section 6+00 W

Section Looking West  
Top of Spoil Bank

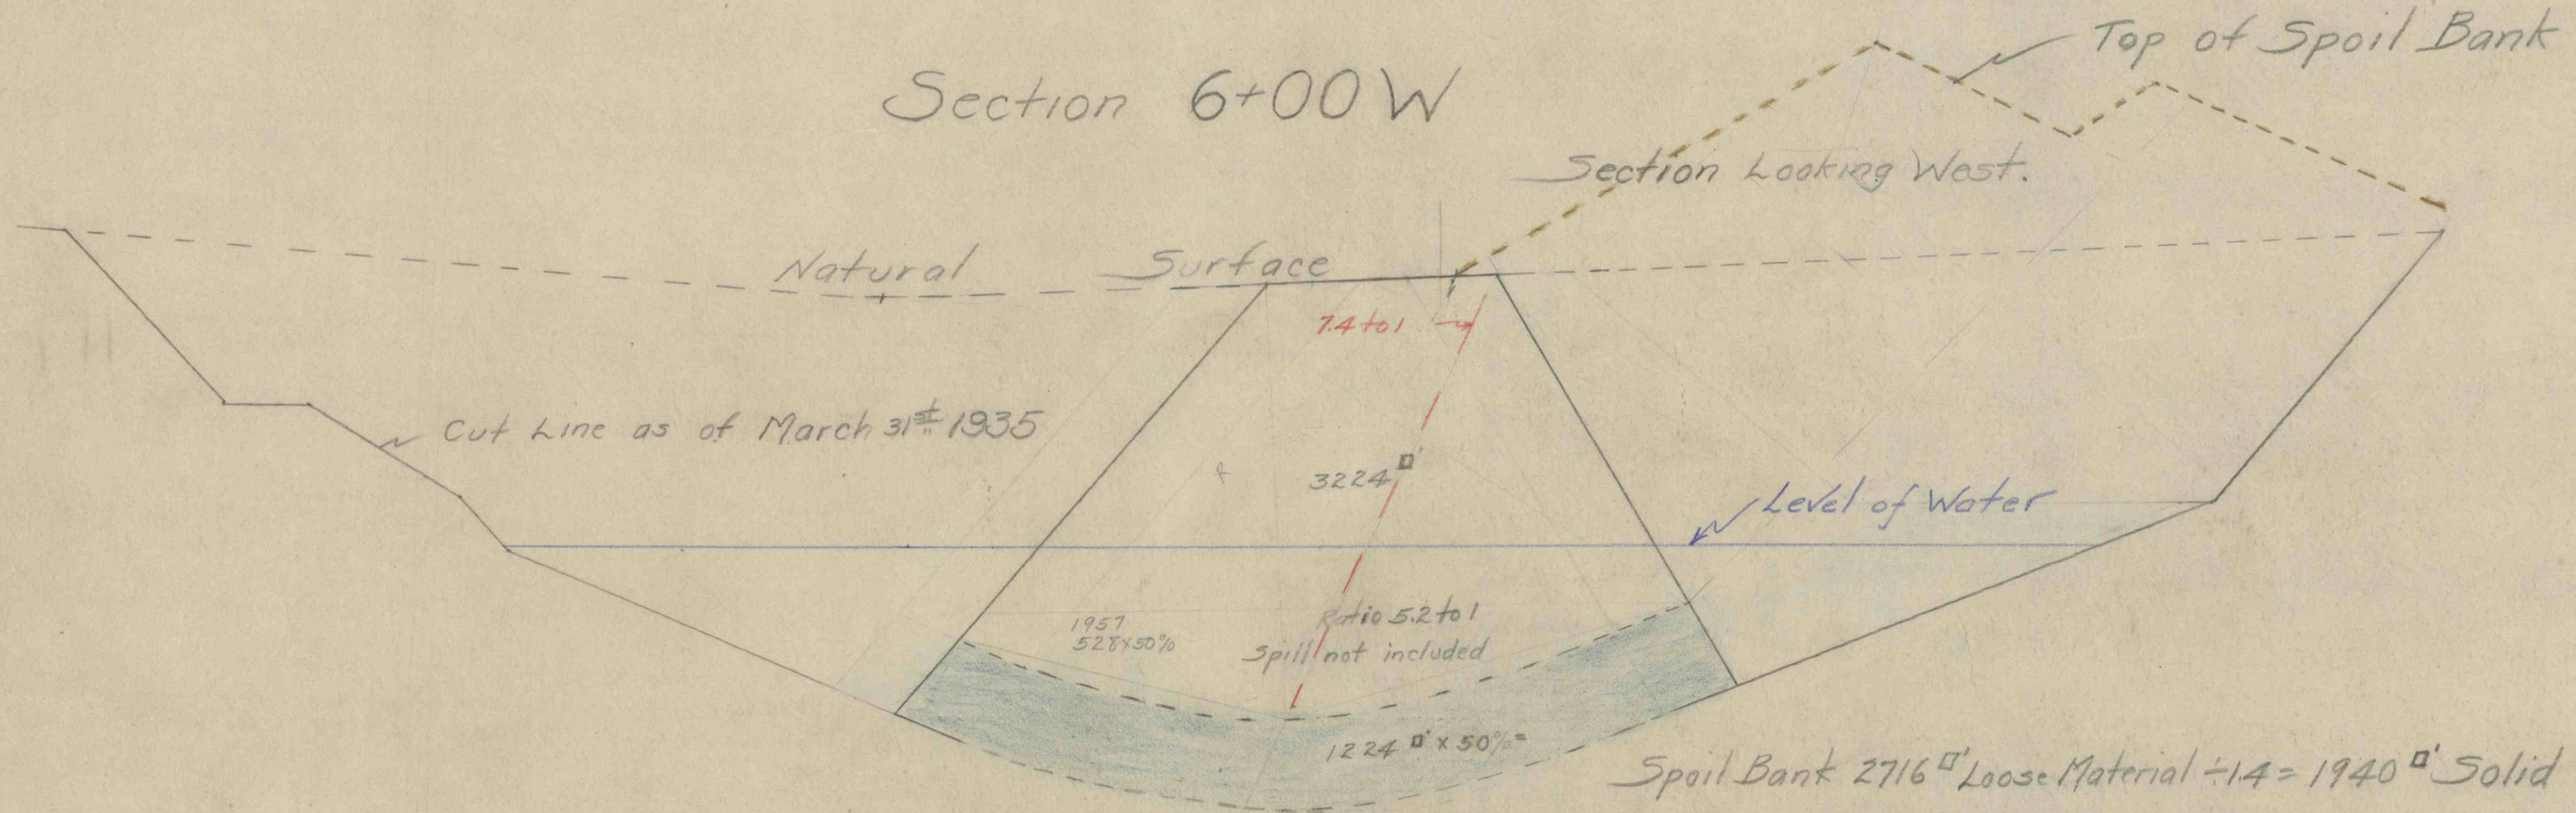


Scale 1" = 20'

850.00

## Section 5+00 W

Section Looking West  
Top of Spoil Bank

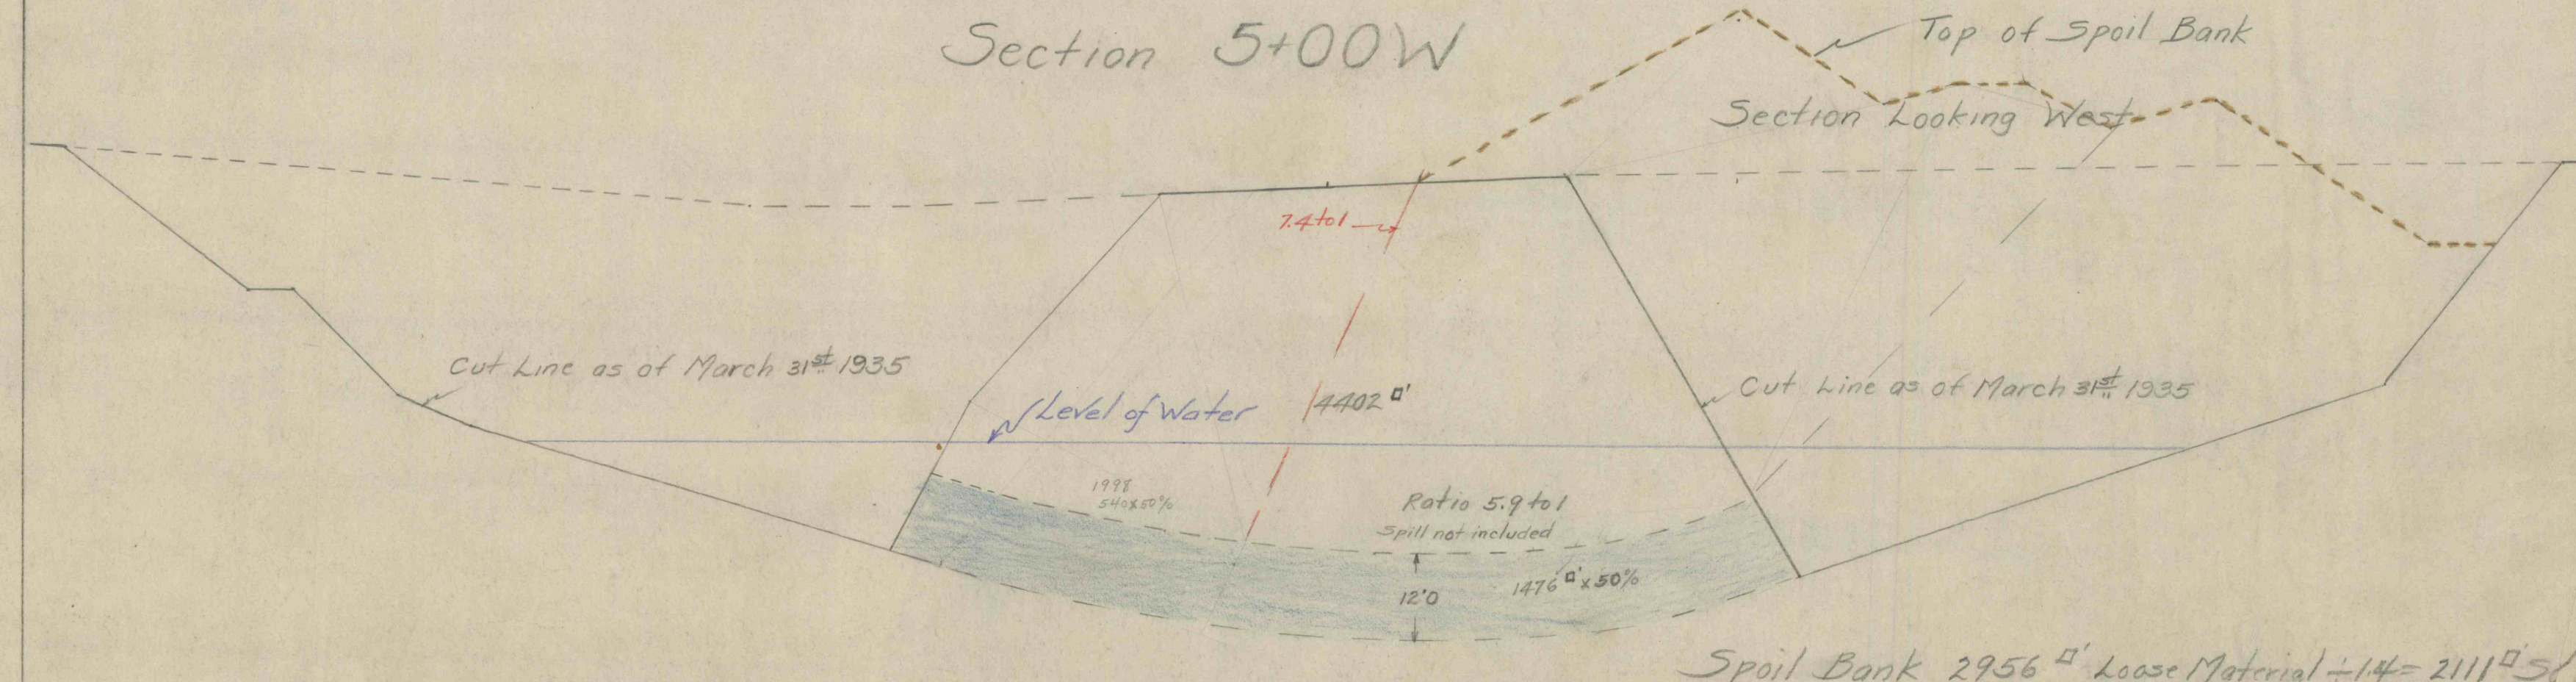

Scale 1" = 20'

4100 N

3100 N

2100 N

2400 N

3100 N

4100 N

IVC-2W-01  
Datum