


Section 4+00 W

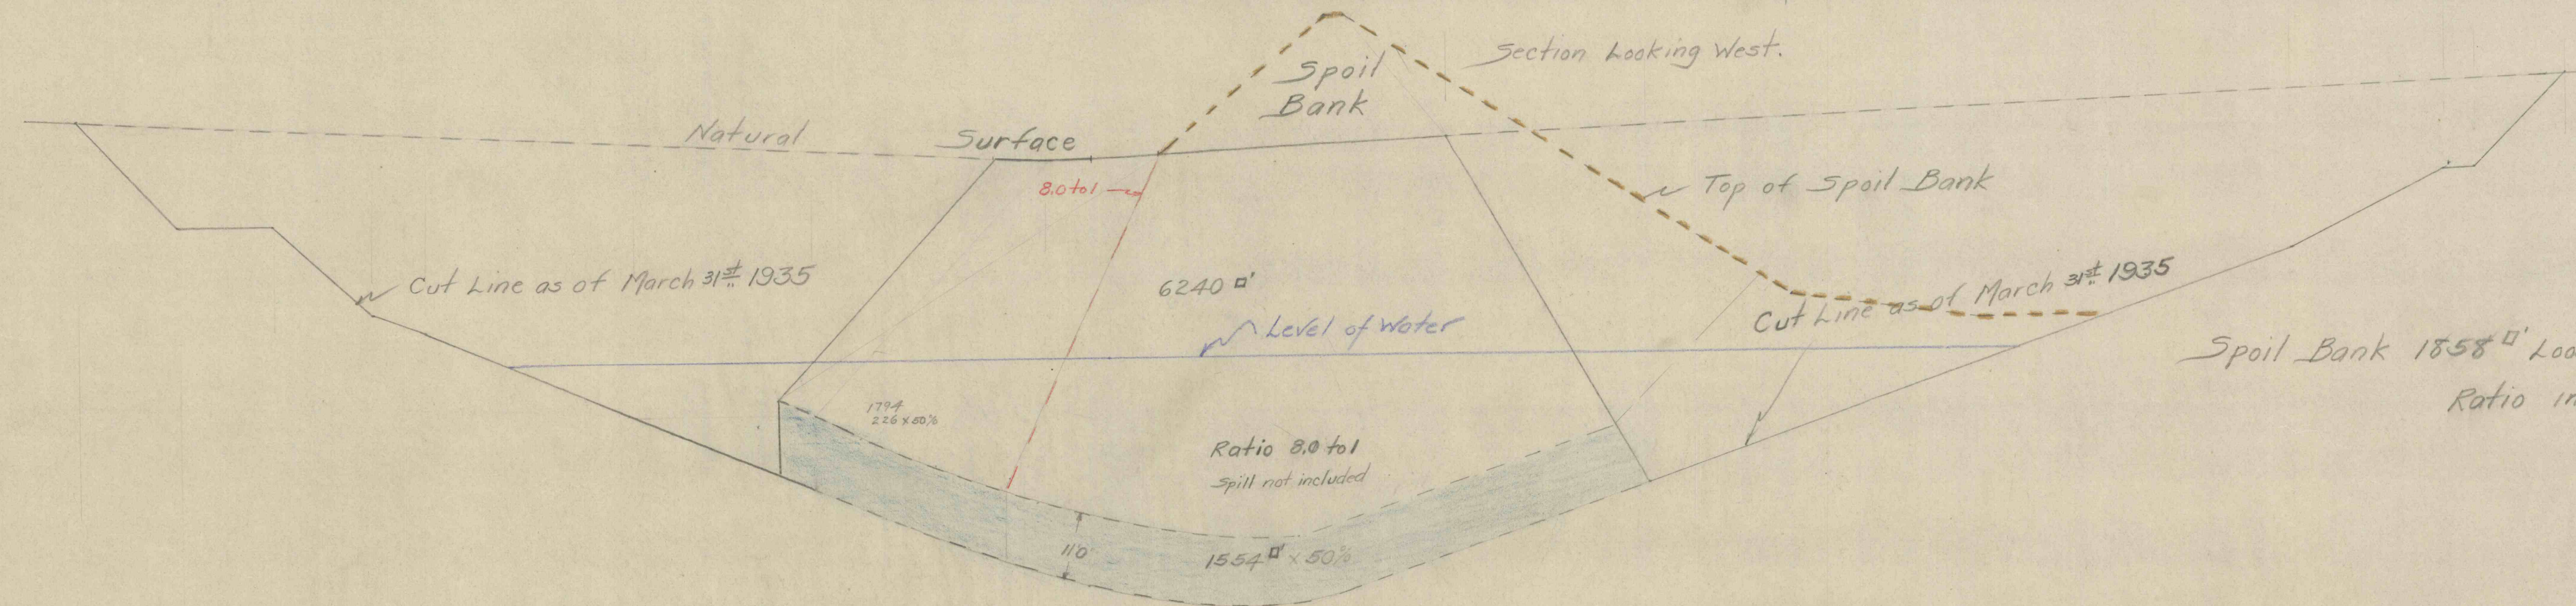

Spoil Bank 1858' Loose Material $\div 1.4 = 1327'$ Solid
Ratio increased to 9.7 to 1

Scale 1" = 20'

Datum 1+00

2+00

3+00

4+00

5+00

850.00