


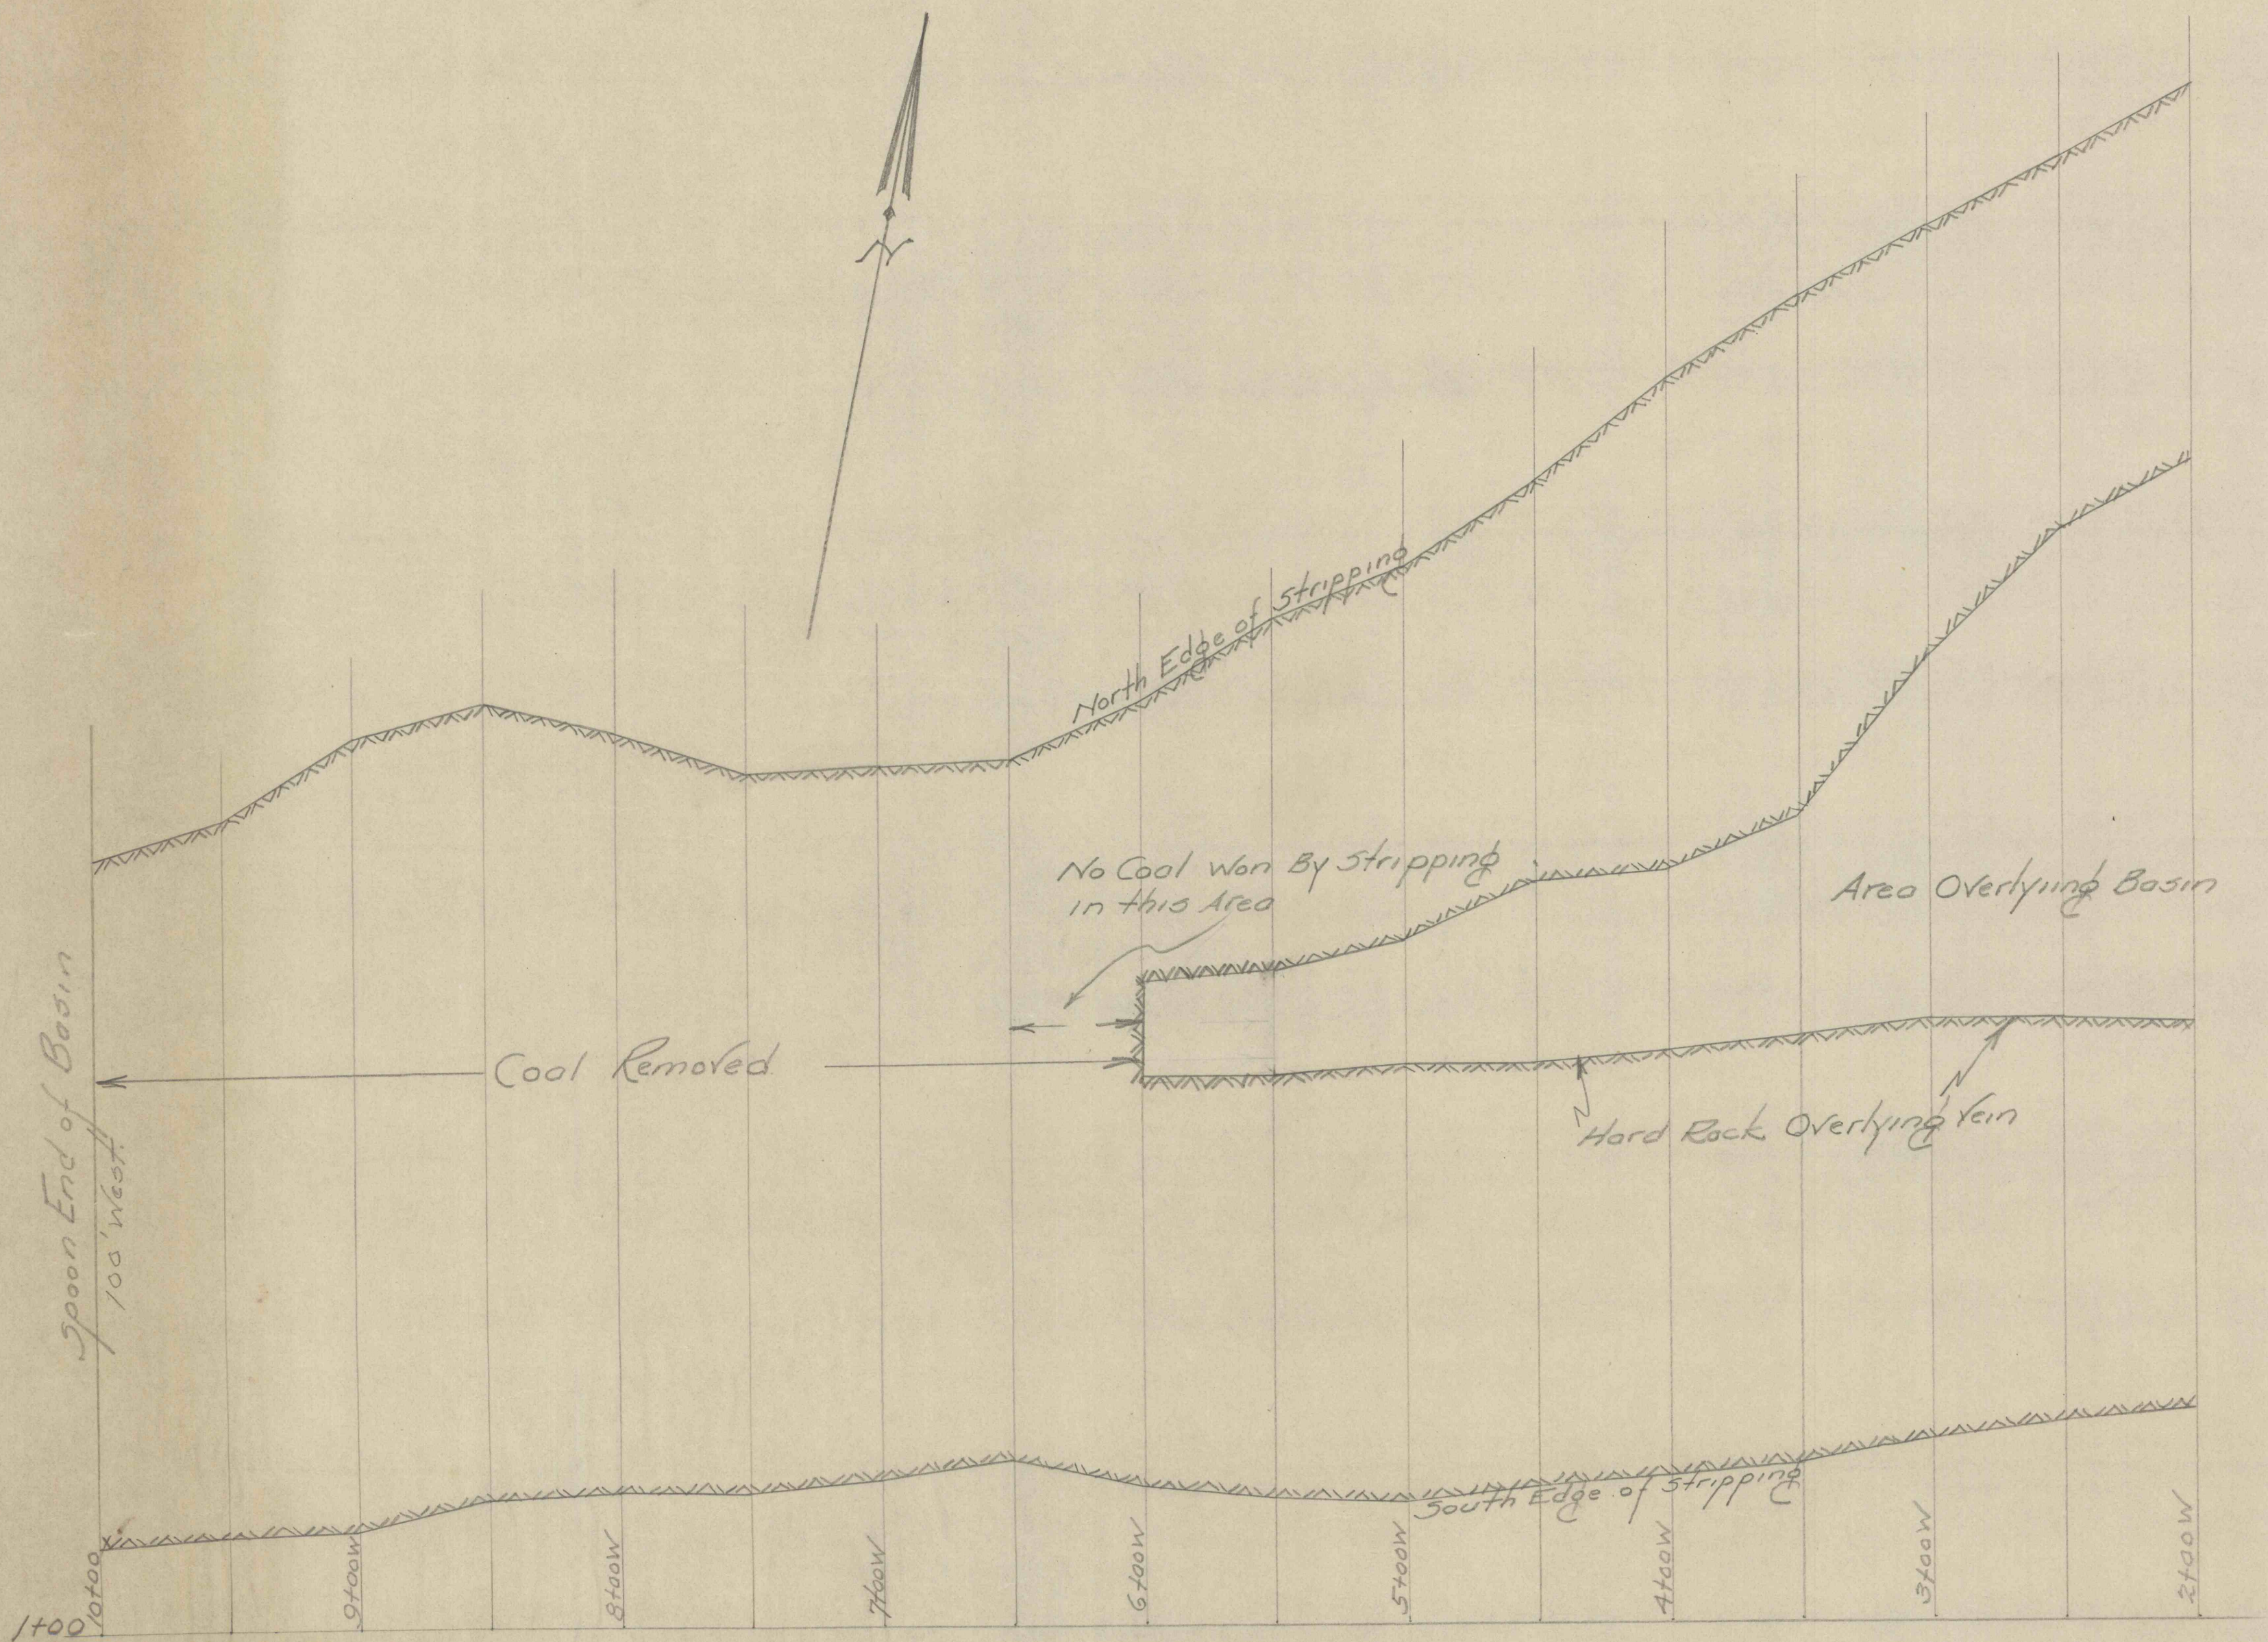

Silver Creek - #42 Buck Mtn Vein Stripping
Scale 1" = 50'