


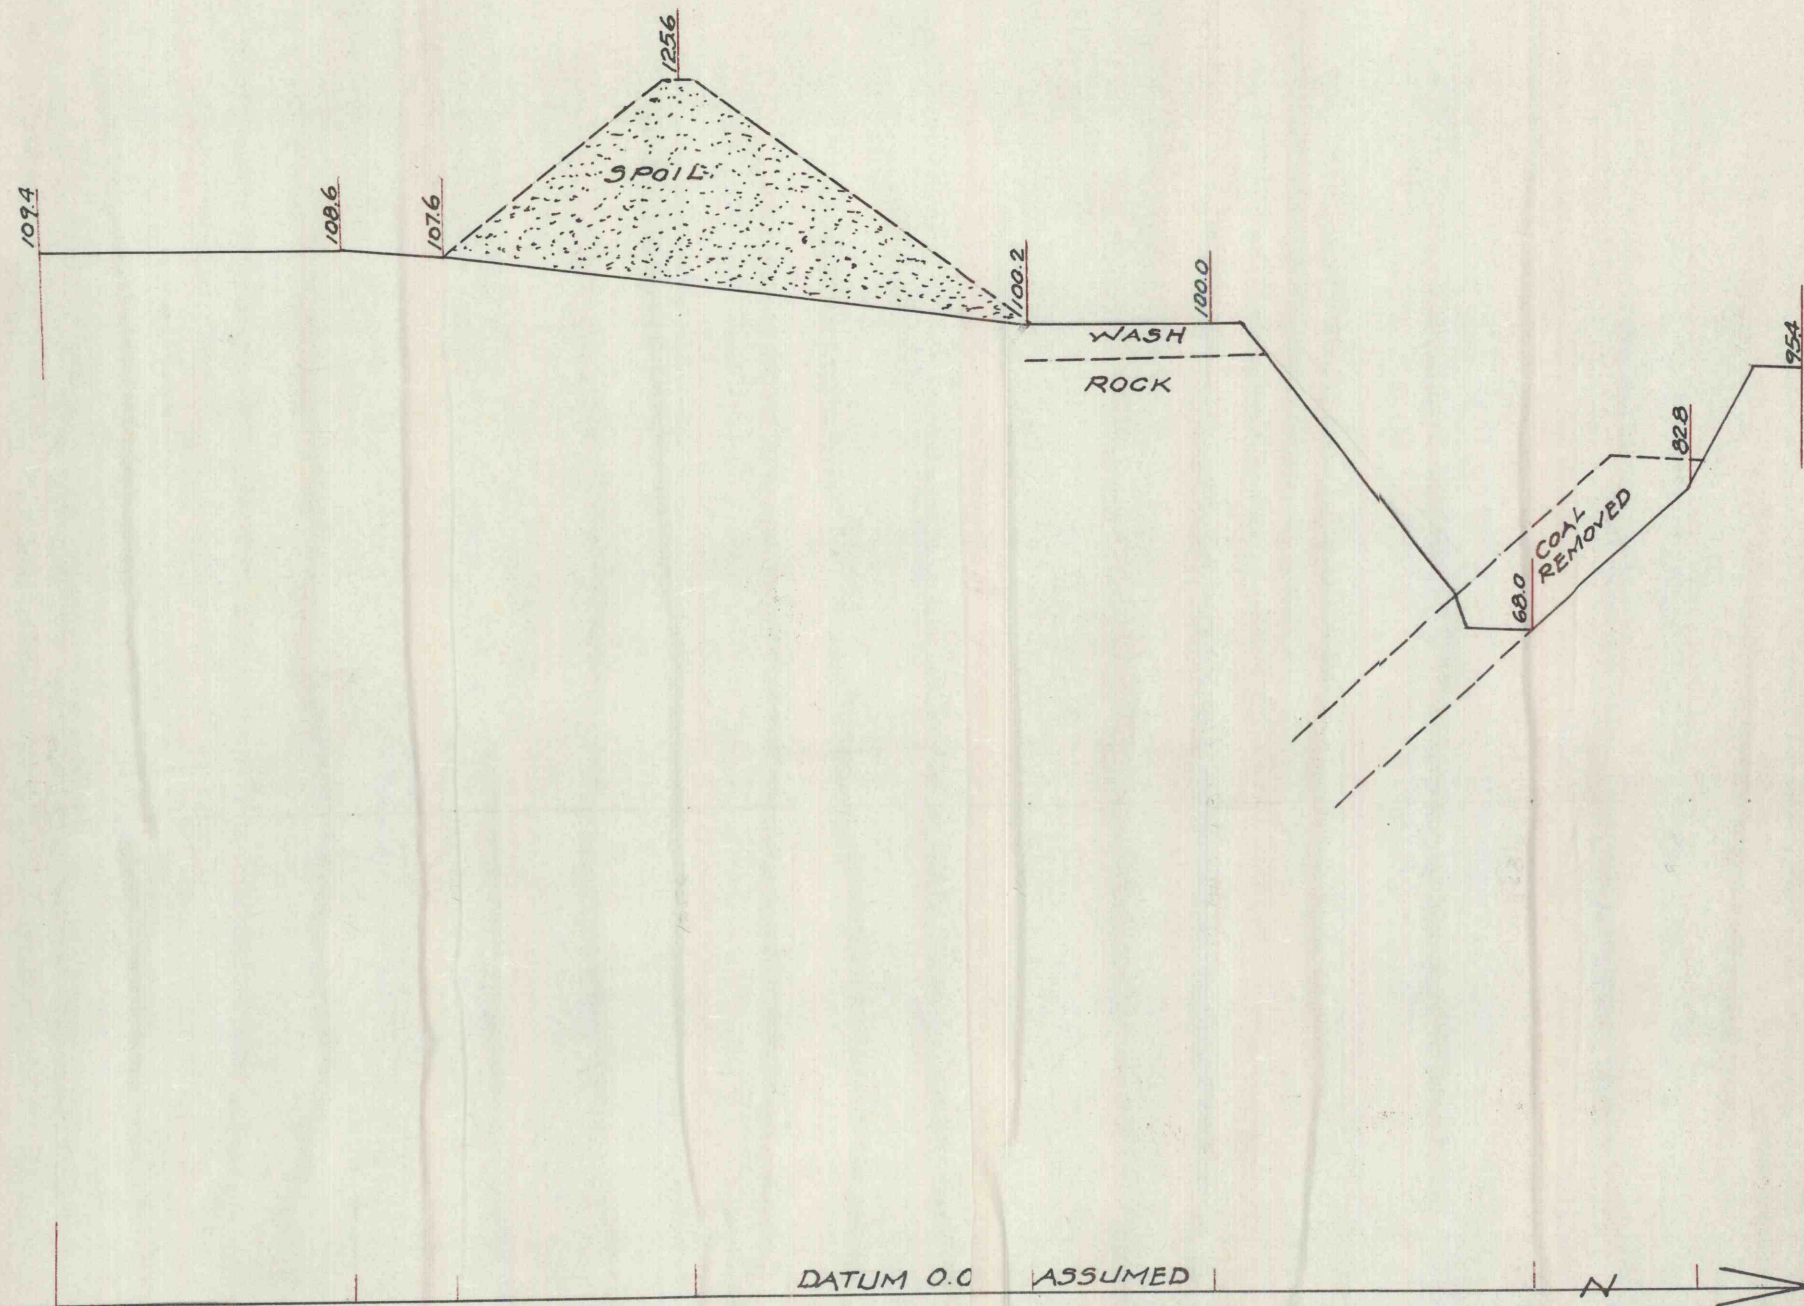

J. ROBERT BAZLEY, Inc.
 POTTSVILLE, PENNA.
 TYPICAL SECTION THROUGH
 N^o 63 DIAMOND VEIN STRIPPING
 AT ST. CLAIR

DATE	SCALE	BY
10-20-44	1"=20'	