


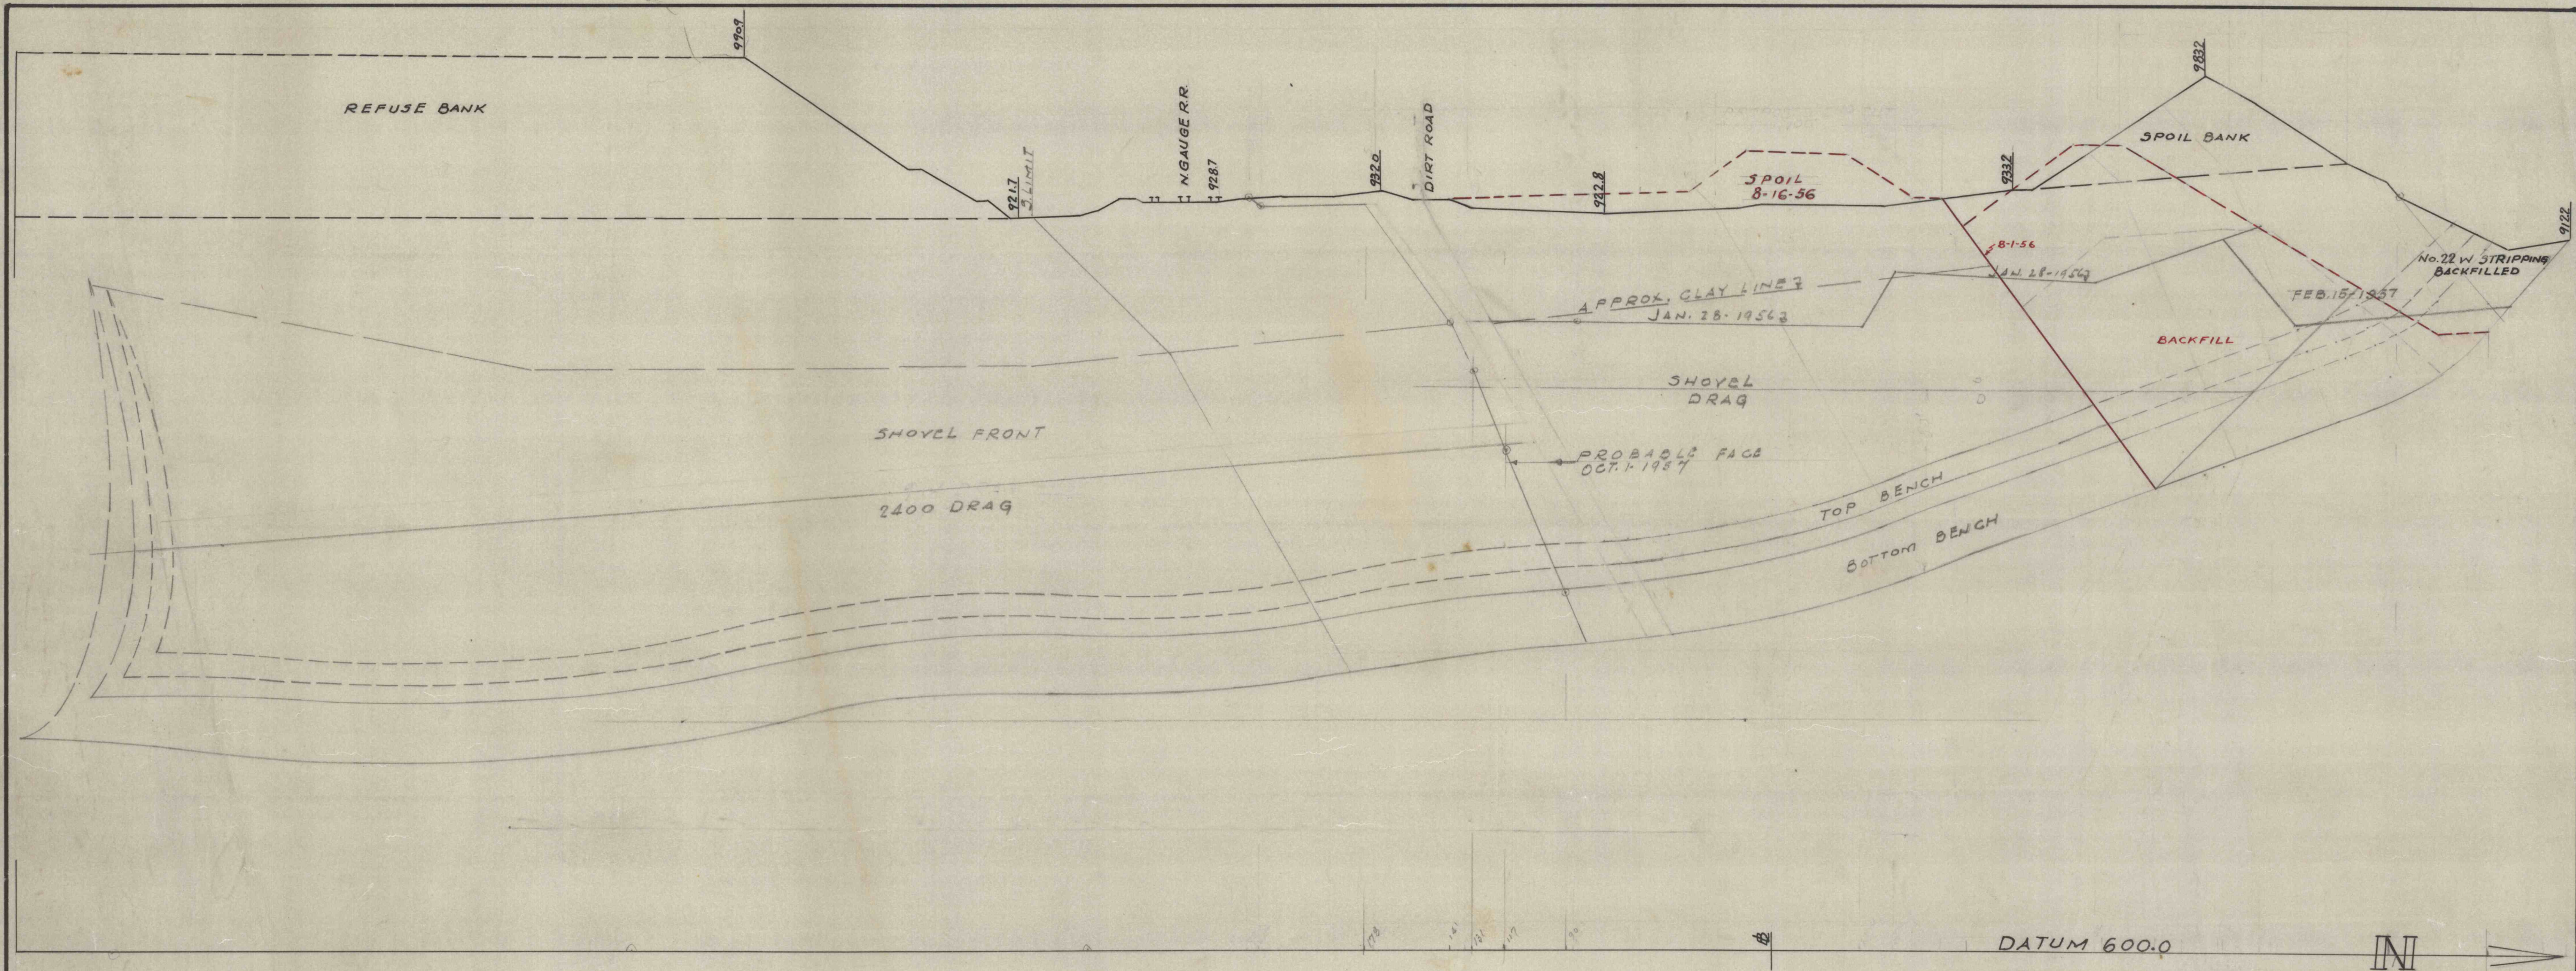

ST. CLAIR COAL CO.
No 22 MAMMOTH VEIN STRIPPING
WEST EXTENSION
SECTION 21+00 WEST
SCALE 1"=50' JUNE 1955
ENG. DEPT. J. ROBERT BAZLEY INC.