


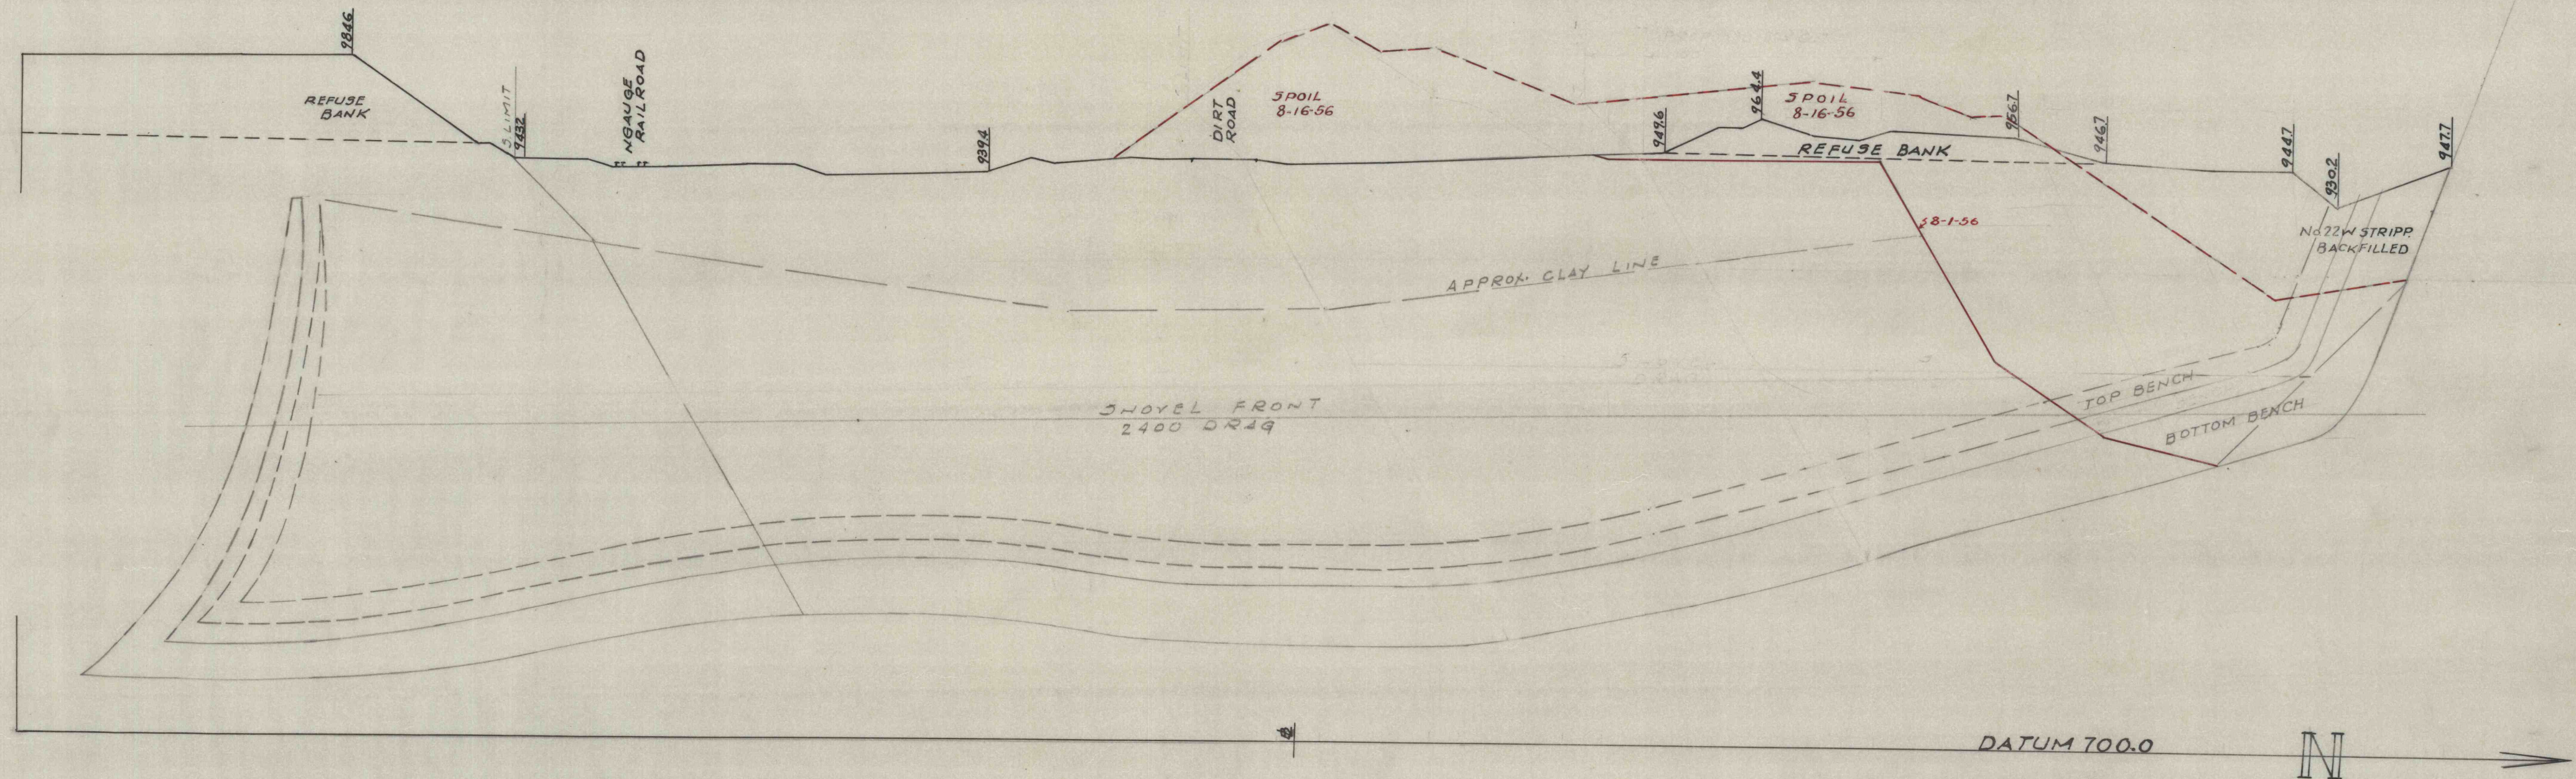

ST. CLAIR COAL CO.
NO. 22 MAMMOTH VEIN STRIPPING
WEST EXTENSION
SECTION 17+00 WEST
SCALE 1"=50' JUNE 3, 1955
ENG. DEPT. J. ROBERT BAZLEY INC.

8-10-M-L-JAT