


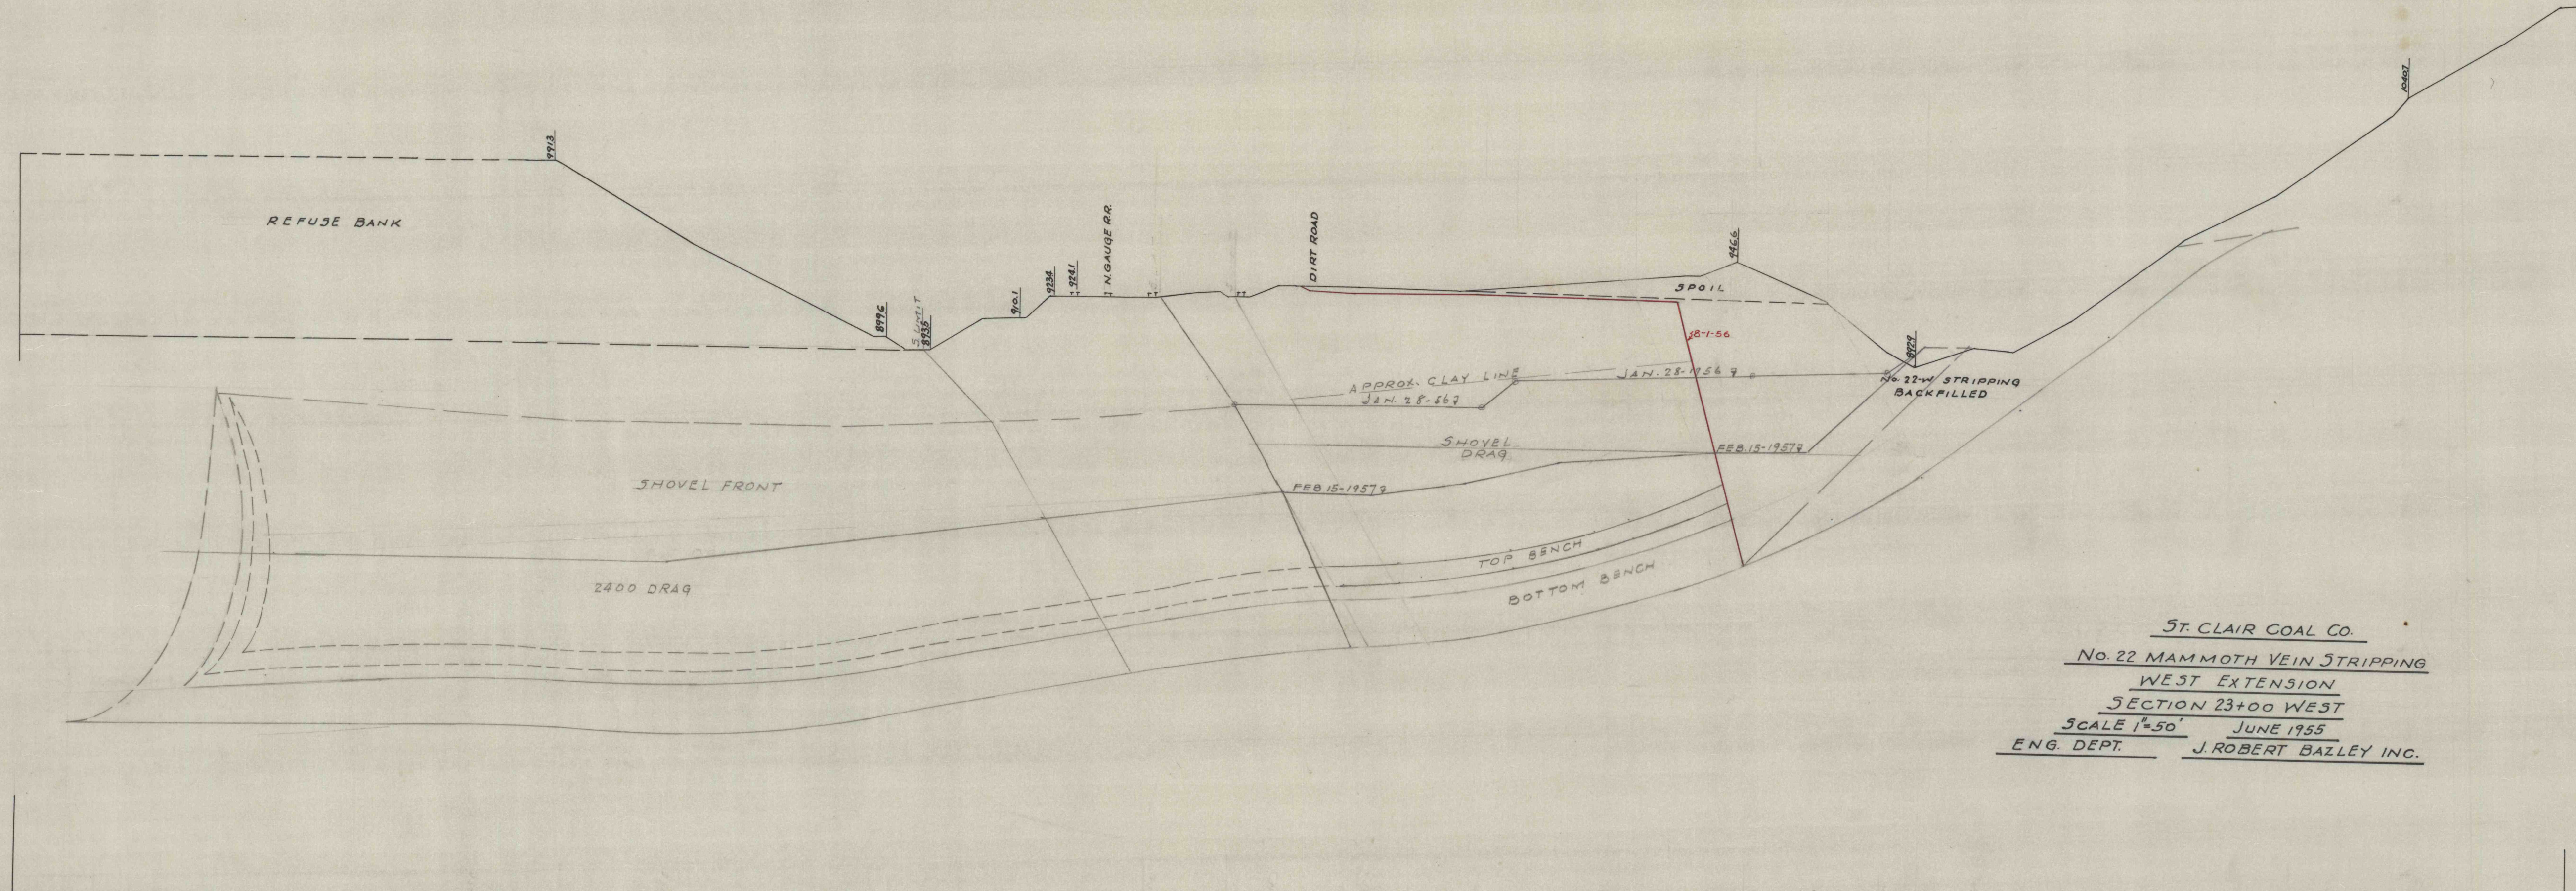

ST. CLAIR COAL CO.
No. 22 MAMMOTH VEIN STRIPPING
WEST EXTENSION
SECTION 23+00 WEST
SCALE 1"=50' JUNE 1955
ENG. DEPT. J. ROBERT BAZLEY INC.