


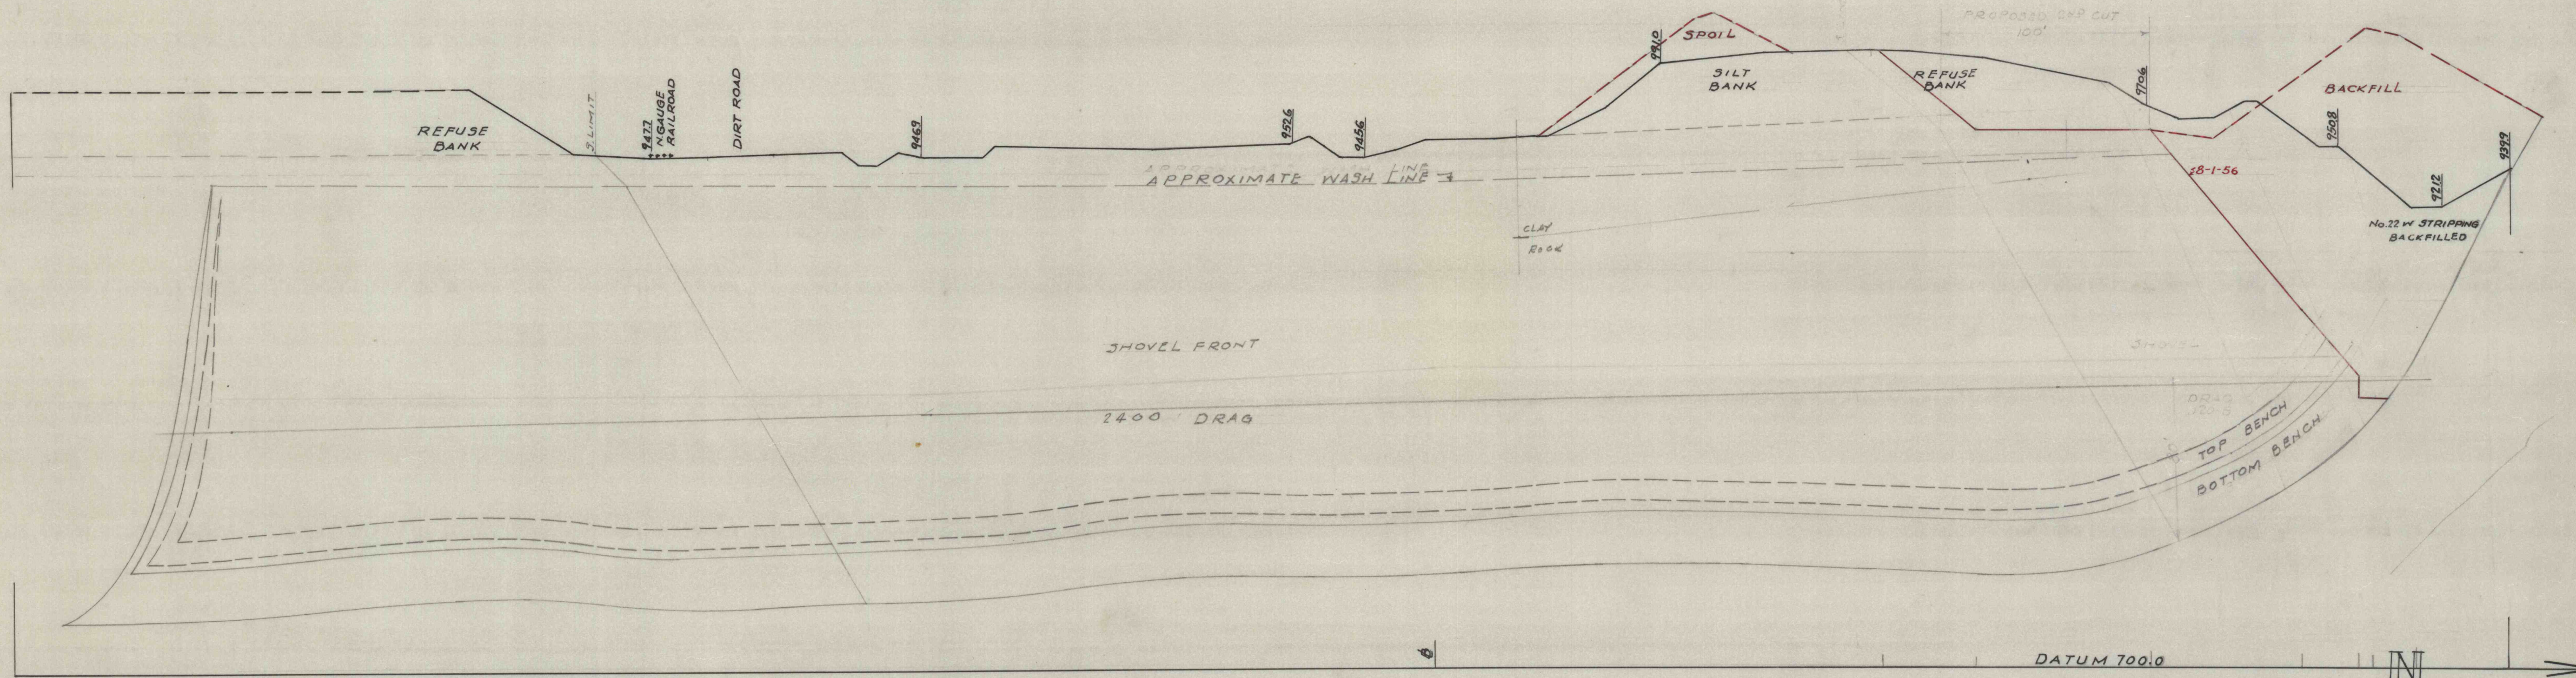

ST. CLAIR COAL CO.
 No. 22 MAMMOTH VEIN STRIPPING
 WEST EXTENSION
 SECTION 15+00 WEST
 SCALE 1"=50' JUNE 3-1955
 ENG. DEPT. J. ROBERT BAZLEY INC.

02510-MC-JAT